

LAND CORNER RECORDATION CERTIFICATE
Filing Requirement of Act 74, Mich. P.A. 1970

For corners in

Dickinson

(County)

Located in:

Corner Code #

1. Public Land Survey

T 43N R 28W H10
T R
T R
T R

2. Property Controlling in Section

S 27 T 43N R 28W 6

3. Miscellaneous Property in Sec.

S T R
S T R
S T R

Register of Deeds Stamp & File Number

4. Lot No. , Recorded Plat
5. Private Claims

6 Jun 13 2001
H10 Jun 05 2001

I, Stephan J. Szyszkoski, in a field survey on , 19 do hereby state that under requirements of P.A. 74, Michigan P.A. of 1970, the corner points mentioned in lines 1 and 2 above were in conformance with regulations and rules therefore as required in the current manual of survey instructions of the United States Department of the Interior, Bureau of Land Management or by a decree of a Court of Law and /or that the corner points mentioned in lines 3, 4 and 5 above were in conformance with the rules of the Michigan Board of Land Surveyors or by a Decree of a Court of Law; established, re-established, monumented, recovered, found as expressed below:

NOTE: Not more than 2 corners, all in the same town and range, may be recorded on this certificate.

1	A	B	C	D	E	F	G	H	I	J	K	L	M
2		6		5		4		3		2		1	
3													
4		7		8		9		10		11		12	
5													
6		18		17		16		15		14		13	
7													
8		19		20		21		22		23		24	
9													
10		30		29		28		27		26		25	
11													
12		31		32		33		34		35		36	
13													

A. Description of original monument and accessories and/or subsequent restoration:

(H10) Center of Section 27. Corner not established in the original survey. 1949 Mich. Dept. of Natural Resources cruiser notes show "WP" on sketch of Section 27.

(6-Sec. 27) Northeast 1/16 corner, Section 27. Corner not established in the original survey. 1949 Mich. Dept. of Natural Resources cruiser notes show "IP" on sketch of section 27.

B. Description of corner evidence found and/or method applied in restoring or reestablishing corner:

(H10) Established and monumented the corner at the intersection of straight lines connecting opposite 1/4 corners. From the position monumented, I found a 3/4" iron rod with a mushroomed top, S10E approx. 35' distant which I did not accept as marking the corner position.

(6-Sec. 27) Established and monumented the corner at the intersection of straight lines connecting opposite 1/16 corners. From the position monumented, I found a 1" iron pipe N80E 7.1' distant which I did not accept for the corner.

C. Description of monument for corner and accessories established to perpetuate locating the position of the corner:

(H10) Set 1"IDx32" iron pipe with 4" alum. MDNR cap. Blazed and scribed:


12" R.Pine N31E 11.8' "C1/4 BT"
9" R.Pine S61E 21.7' do
12" R.Pine S19W 32.0' do
6" R.Pine N73W 9.3' do

Set sq'd spruce post adjacent. Bearings are magnetic. Distances to notch in lower blaze.

(6) Set 1"IDx32" iron pipe with 4" alum. MDNR cap. Blazed and scribed:

12" R.Pine S65E 14.3' "1/16S 8T"
10" R.Pine S12E 30.4' do
24" Twin Oak S45W 34.0' do
12" W.Pine N78W 10.9' do

Set sq'd cedar post adjacent. Bearings are magnetic. Distances are to notch in lower blaze.

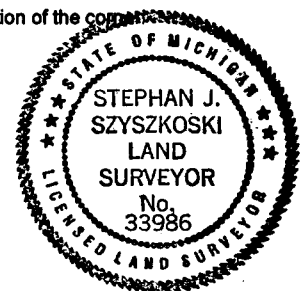

Signed by Stephan J. Szyszkoski
Surveyor's Michigan License No. 33986

Date 7/18/01

For the Michigan Department of Natural Resources - Forest Management Division