

LAND CORNER RECORDATION CERTIFICATE
Filing Requirement of Act 74, Mich. P.A. 1970 as Amended

For corners in

Dickinson

(County)

Located In:

Corner Code #

1. Public Land Survey

T 44N R 29W

M2

T R

T R

S T R

2. Property Controlling
in Section

S 1 T 44N R 29W

7

S T R

3. Miscellaneous
Property in Sec.

S T R

S T R

4. Lot No. , Recorded Plat

5. Private Claims

Aug 10 2004

I, Stephan J. Szyszkoski, in a field survey on _____, 20____ do hereby state that under requirements of P.A. 74, Michigan P.A. of 1970, the corner points mentioned in lines 1 and 2 above were in conformance with regulations and rules therefore as required in the current manual of survey instructions of the United States Department of the Interior, Bureau of Land Management or by a decree of a Court of Law and /or that the corner points mentioned in lines 3, 4 and 5 above were in conformance with the rules of the Michigan Board of Land Surveyors or by a Decree of a Court of Law; established, re-established, monumented, recovered, found as expressed below:

NOTE: Not more than 2 corners, all in the same town and range, may be recorded on this certificate.

A. Description of original monument and accessories and/or subsequent restoration:

(M2) Quarter corner common to Section 1 T44N-R29W and Section 6 T44N-R28W. 1956 - Restored by Billy D. Buckler RLS: Replaced 1/4 corner from one W.Pine Stp. (probable BT) badly burned. Possible trace of stake in soil. Distance checked South to ravine, swamp edge, stream. Found old blazes both north and south of here. Set 1"iron pipe with 4" brass cap. 14" Red Pine N77W 58 links, 18" W.Pine S32E 82 links.

(7-Sec. 1) North 1/16 corner between Section 1 T44N-R29W and Section 6 T44N-R28W. Not established in the original survey.

B. Description of corner evidence found and/or method applied in restoring or reestablishing corner:

(M2) Recovered the 1956 monument in good condition and at record bearing and distance from the 1956 witnesses. The W.Pine is standing dead with scribing and measuring notch visible. The R.Pine is in good condition with scribing and notch visible. Accepted the monument and used it to control the establishment of the 1/16 corner to the north (corner #7, Sec. 1)

(7-Sec. 1) Established the corner on a straight line between M2 1318.02' south and M1 1410.28' north, said point being 20 chains north of M2, proportionate to the dimensions on the original Government Plat.

C. Description of monument for corner and accessories established to perpetuate locating the position of the corner:

(M2) Found 1"ID I.pipe with 4" brass cap. Blazed, scribed, and set measuring nails in:

6" double Maple N50E 24.9' "1/4S NBT"

16" double Oak S50E 73.0' do

8" Maple S07W 38.3' do

the 1956 NBT:

17" R.Pine N72W 38.2' old iron marks

A sq'd cedar post is adjacent. Bearings

are magnetic. Distances are to nail

with tag.

(7) Set 1"IDx32" I.pipe with 4" alum.

MDNR cap. Blazed, scribed, and set measuring nails in:

13" R.Pine N29E 31.2' "1/16S BT"

5" W.Pine N89E 34.1' do


12" Poplar S04W 12.2' do

6" J.Pine S76W 37.5' do

Set sq'd spruce post adjacent. Bearings

are magnetic. Distances are to nail

with tag.

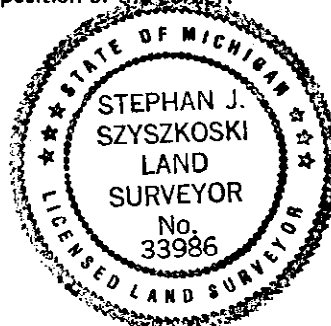

Signed by

Stephan J. Szyszkoski

Surveyor's Michigan License No.

33986

Date

8/17/04

For the Michigan Department of Natural Resources, Office of Land and Facilities

FORM APPROVED BY MICHIGAN STATE BOARD OF PROFESSIONAL SURVEYORS, JAN. 28, 1971

Revised May 14, 1975

Revised Jan., 1983

Revised Oct., 1995