

DEC 16 1996

COMMISSION

LAND CORNER RECORDATION CERTIFICATE

Filing Requirement of Act 74, Mich. P.A. 1970

For corners in

EATON Located in: Corner Code K-9  
(County)

VERMONTVILLE TOWNSHIP

1. Public Land Survey T 3N R 6W K-9  
T     R      
T     R      
T     R    

2. Property Controlling S     T     R      
in Section S     T     R    

3. Miscellaneous S     T     R      
Property in Sec. S     T     R    

4. Lot No.           , Recorded Plat           

5. Private Claims           

FILED

96 OCT 17 PM 3:26

LINDA M. TWITCHELL  
REGISTER OF DEEDS  
EATON COUNTY, MICH.

Register of Deeds Stamp & File Number

LIBER 3 PAGE 222

	A	B	C	D	E	F	G	H	I	J	K	L	M
2	6	5	4	3	2	1							
3													
4	7	8	9	10	11	12							
5													
6	18	17	16	15	14	13							
7													
8	19	20	21	22	23	24							
9													
10	30	29	28	27	26	25							
11													
12	31	32	33	34	35	36							
13													

I, RONALD L. ENGER, in a field survey on AUGUST 20, 19 96, do hereby certify that under requirements of P.A. 74, Michigan P.A. of 1970, the corner points mentioned in lines 1 and 2 above were in conformance with regulations and rules therefore as required in the current manual of survey instructions of the United States Department of the Interior, Bureau of Land Management or by a decree of a Court of Law and/or that the corner points mentioned in lines 3, 4 and 5 above were in conformance with the rules of the Michigan Board of Land Surveyors or by a Decree of a Court of Law; established, re-established, monumented, re-monumented, recovered, found as expressed below:

NOTE: Not more than 4 corners, all in the same town and range, may be recorded on this certificate.

A. Description of original monument and accessories and/or subsequent restoration:

1. POST SET IN ORIGINAL GOVERNMENT SURVEY BY ORANGE RISDON, DEPUTY SURVEYOR IN MARCH 1827. WITNESSES: BEECH 10" S38°E 4LKS. SUGAR MAPLE 8" N74°W 50LKS.

2. J.H. GIBBONS, COUNTY SURVEYOR, USED CORNER IN A SURVEY IN MAY 1868 AS A STAKE, CROCKERY AND GLASS WITH NO MENTION OF WITNESSES.

CONTINUED ON BACK.

B. Description of corner evidence found and/or method applied in restoring or reestablishing corner:


SEARCHED AT APPARENT LOCATION OF CORNER AND FOUND 1/2" BAR AND CAP #18988(D. FLUKE) 5.5' SOUTH AND 3' WEST OF CENTERLINE INTERSECTION VERMONTVILLE HIGHWAY AND SHAYTOWN ROAD. TRAVERSED TO FLUKE'S IRON FROM 1/4 CORNERS IN ALL FOUR DIRECTIONS AND TO NAIL AND TAG AT 1/8TH CORNER TO THE WEST THAT D. FLUKE SET FROM EXISTING 1920 WITNESSES. CORNER IS ON LINE WITH 1/4 CORNER AND 1/8TH CORNER TO THE WEST AND IS SAME DISTANCE EAST OF 1/8TH CORNER AS 1/8TH CORNER IS EAST OF 1/4 CORNER. STRAIGHT GLO PRORATION IN EAST-WEST DIRECTION AGREES WITH POSITION OF CORNER EXACTLY. LOCATION OF CORNER HAS BEEN CUT AND FILLED AT LEAST THREE TIMES SINCE 1919. LIKELIHOOD OF FINDING STONE IS NIL AS HARVEY WILLIAMS DID NOT FIND IT IN 1919. ACCEPTED BAR AND CAP AS PERPETUATION OF CORNER AND REPLACED IT WITH 3/4" BAR AND PA345 CAP LS28409 AND MONUMENT BOX.

C. Description of monument for corner and accessories established to perpetuate locating the position of the corner:

K-9 T3N R6W  
3/4" DIAMETER X 24" LONG SMOOTH STEEL BAR AND CAP IMPRINTED "PA 345 PS 28409" IN MONUMENT BOX  
CENTERLINE VERMONTVILLE HIGHWAY 5.5' NORTH  
CENTERLINE SHAYTOWN ROAD 3.0' EAST  
NAZ 16° NAIL AND TAG 28409 W. SIDE POWER POLE 202.46'  
NAZ 45° NAIL AND TAG 28409 N.W. SIDE 16" MAPLE 181.32'  
NAZ 135° 1/2" PIPE AND CAP "REED" 46.22'  
NAZ 279° NAIL AND TAG 28409 S. SIDE 36" MAPLE 265.45'  
NAZ 338° NAIL AND TAG 28409 E. SIDE 30" MAPLE 77.28'

Signed by R. L. Enger Date AUGUST 20, 1996

Surveyor's Michigan License No. 28409

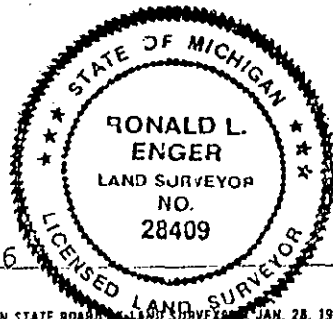

FORM APPROVED BY MICHIGAN STATE BOARD OF LAND SURVEYORS, JAN. 28, 1971  
REVISED MAY 14, 1975  
REVISED JAN., 1983

P.A. 345 EATON COUNTY

PEER APPROVED 8/29/96 M

K-9 T1N R3W  
PART A CONTINUED:

3. J.H. GIBBONS USED CORNER IN FEBRUARY 1869 AS A STONE AND CROCKERY
4. HIGHWAY PLANS OF 1919 SURVEYED BY H.A. WILLIAMS CALL FOR SECTION CORNER(APPROXIMATE) IRON STAKE.  
MAPLE 16" N.W. 43.2'  
ANCHOR POST S.W. 46.2'
5. HIGHWAY PLANS OF 1920 SHOW STONE AND WITNESSES AT 1/8TH CORNER, 1/4 MILE WEST.
6. HIGHWAY PLANS OF 1920 SHOW STONE AND WITNESSES AT 1/4 CORNER 1/2 MILE WEST.
7. DON FLUKE LS 18988 SET 1/2" BAR AND CAP AT CORNER USING 1/4 CORNER AND 1/8 CORNER TO THE WEST FOR LINE AND DISTANCE.