

MAR 04 1998

STATE OF MICHIGAN
EMMET COUNTY
RECORDED

LAND CORNER RECORDATION CERTIFICATE
Filing Requirement of Act 74, Mich. P.A. 1970

97 DEC 29 PM 3:09

SECTION

For corners in

Emmet
(County)

Located In:

Corner Code #

Glenn B. Sizer
REGISTER OF DEEDS

1. Public Land Survey

ECRP #139

T 37N R 5W

M-11

T R

T R

T R

T R

2. Property Controlling
in Section

S T R

S T R

3. Miscellaneous
Property in Sec.

S T R

S T R

LIBER

A

PAGE 170

Register of Deeds Stamp & File Number

4. Lot No. _____, Recorded Plat _____

5. Private Claims _____

I, Thomas D. Swenor, in a field survey on 12/19, 19 97, do hereby certify that under requirements of P.A. 74, Michigan P.A. of 1970, the corner points mentioned in lines 1 and 2 above were in conformance with regulations and rules therefore as required in the current manual of survey instructions of the United States Department of the Interior, Bureau of Land Management or by a decree of a Court of Law and/or that the corner points mentioned in lines 3, 4 and 5 above were in conformance with the rules of the Michigan Board of Land Surveyors or by a Decree of a Court of Law; established, re-established, monumented, re-monumented, recovered, found as expressed below:

NOTE: Not more than 4 corners, all in the same town and range, may be recorded on this certificate.

A. Description of original monument and accessories and/or subsequent restoration:

M-11, Section Corner common to Sections 25, and 36, T37N R5W
and Section Corner common to Sections 30, and 31, T37N R4W (A-11)

Date	Surveyor	Found	Witnesses
1840	GLO	Set Sec. Post	(1) Cedar 8 S21W 06 (2) unknown 6 S18E 15

1982	K.J. Ostling (DNR)	Set P.K. Nail at intersection of Camp Road (east/west) and Ely Bridge Road (north), in line with fence south.
------	--------------------	---

B. Description of corner evidence found and/or method applied in restoring or reestablishing corner:

M-11,
Found P.K. Nail in road intersection as set by K.J. Ostling. Fence line extends south from P.K. Nail At Northeast corner of intersection found 3' by 3' field stone and concrete pillar, (3-1/2' high). As noted in C. (3) N46°30'E 46.83' to pillar (4th rock down from top.) This very well harmonizes with typical right-of-way corner placement at intersections. Mr. Gosi Suarez, adjacent landowner since early 1940's, states: "Pillars placed by his neighbor in the early 1940's."

THE P.K. NAIL IS ACCEPTED BY THE EMMET COUNTY REMONUMENTATION PROGRAM AS A CAREFUL AND FAITHFUL PERPETUATION OF THE ORIGINAL CORNER.


APPROVED LAND CORNER
P.A. 345 OF 1990
Emmet County
B.E. Oelke
ECRP. Rep
12-30-97

C. Description of monument for corner and accessories established to perpetuate locating the position of the corner:

M-11,
Found P.K. Nail and replaced with a 2" diameter, 30" long PVC Pipe with abase magnet and a standard brass Emmet County Remonumentation Cap.

Witnesses:

- (3) N46°30'E 46.83' - 3' x 3' Stone Pillar (4th stone down from top, at SW'ly edge)
- (4) S05°W 53.35' - Power Pole, PN2 64 v m (set spike nail with 37282 cap)
- (5) S34°E 61.23' - 12" Maple (set spike nail with 37282 cap)
- (6) S58°E 64.29' - 12" Maple (set spike nail with 37282 cap)

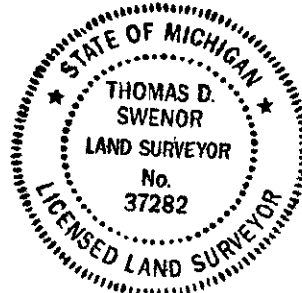

Signed by Thomas D Swenor

Date 12/29/97

Surveyor's Michigan License No. 37282