

APR 27 1995

1994 REMONUMENTATION PROGRAM

COMMISSION

LAND CORNER RECORDATION CERTIFICATE
Filing Requirement of Act 74, Mich. P.A. 1970

For corners in

GENESEE
(County)Located in:
GAINES

Corner Code: 11

1. Public Land Survey T 6N R 5E F-3
T R
T R
T R
2. Property Controlling S T R
in Section S T R
3. Miscellaneous S T R
Property in Sec. S T R

4. Lot No. , Recorded Plat
5. Private Claims

DAVID J. KENNEY, PS in a field survey on, NOVEMBER 8, 19 94
do hereby certify that under requirements of P.A. 74, Michigan P.A. of 1970, the corner points mentioned in lines 1 and 2 above were in conformance with regulations and rules therefore as required in the current manual of survey instructions of the United States Department of the Interior, Bureau of Land Management or by a decree of a Court of Law and/or that the corner points mentioned in lines 3, 4 and 5 above were in conformance with the rules of the Michigan Board of Land Surveyors or by a Decree of a Court of Law; established, re-established, monumented, re-monumented, recovered, found as expressed below:

NOTE: Not more than 4 corners, all in the same town and range, may be recorded on this certificate.

A. Description of original monument and accessories and/or subsequent restoration:

1823 GLO; JOHN MULLETT, D.S. - SET POST - NO ACCESSORIES
1878 WILLIAM B. SEARS, D.S. - FOUND WHITE OAK POST - 2 ACCESSORIES
1966 DENNIS GRIGGS, R.L.S. - SET 1/2" IRON ROD W/CAP #23511 - NO ACCESSORIES

B. Description of corner evidence found and/or method applied in restoring or reestablishing corner:

1994 GENESEE COUNTY REMONUMENTATION PROGRAM
FOUND 1/2" IRON ROD W/CAP #23511

Ratified by Peer Group in
accordance with P.A. 345, 1990


Co. Rep. David J. Kenney
Date 12-28-94

RATIFIED BY GENESEE COUNTY PEER GROUP DECEMBER 28, 1994

C. Description of monument for corner and accessories established to perpetuate locating the position of the corner:

SET STANDARD GENESEE COUNTY MONUMENT

N45°E 18.55' SET P.K. & GC TAG, NW FACE, 10" MAPLE
S45°E 14.40' SET P.K. & GC TAG, NE FACE, 10" POPLAR
WEST 25.0' TO N-S FARM FENCE
N60°W 17.41' FOUND NAIL & TAG IN 8" THORNAPPLE TREE
N40°W 31.90' SET P.K. & GC TAG IN 14" OAK
2654.67' S 1/4 COR. TO SW COR.
2688.62' -S 1/4 COR. TO SE COR.

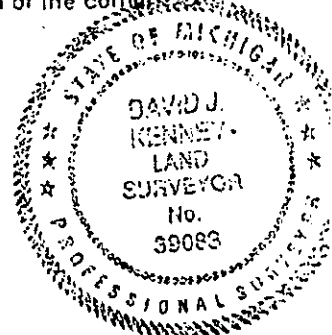

Signed by David J. Kenney

Date DECEMBER 31, 1994

Surveyor's Michigan License No. 39083