

DEC 16 1996

COMMISSION

GLADWIN COUNTY REMONUMENTATION

LAND CORNER RECORDATION CERTIFICATE  
Filing Requirement of Act 74, Mich. P.A. 1970

LIBER 001 PAGE 136

For corners in

GLADWIN (County)	Located In:	Corner Code #
1. Public Land Survey	T 20N R 1W	C - 6
	T R	
	T R	
	T R	
2. Property Controlling in Section	S T R	
	S T R	
3. Miscellaneous Property in Sec.	S T R	
	S T R	

STATE OF MICHIGAN  
GLADWIN COUNTY  
FILED-REMONUMENTATION

2 DEC 96 3:31 P.M.

BONNIE K. HOUSE  
REGISTER OF DEEDS

Register of Deeds Stamp & File Number

4. Lot No. \_\_\_\_\_, Recorded Plat \_\_\_\_\_  
5. Private Claims \_\_\_\_\_

I, MARK ROBISON, in a field survey on November, 1996, do hereby state that under requirements of P.A. 74, Michigan P.A. of 1970, the corner points mentioned in lines 1 and 2 above were in conformance with regulations and rules therefore as required in the current manual of survey instructions of the United States Department of the Interior, Bureau of Land Management or by a decree of a Court of Law and /or that the corner points mentioned in lines 3, 4 and 5 above were in conformance with the rules of the Michigan Board of Land Surveyors or by a Decree of a Court of Law; established, re-established, monumented, recovered, found as expressed below:

NOTE: Not more than 2 corners, all in the same town and range, may be recorded on this certificate.

A	B	C	D	E	F	G	H	I	J	K	L	M
1												
2	6	5			4		3		2		1	
3												
4	7	8			9		10		11		12	
5												
6	18	17			16		15		14		13	
7												
8	19	20			21		22		23		24	
9												
10	30	29			28		27		26		25	
11												
12	31	32			33		34		35		36	
13												

A. Description of original monument and accessories and/or subsequent restoration:

1856 GEO E. ADAIR SET 1/4 POST  
WIT.-(1)ASPEN 5 N70 1/2E 54  
(2)ASPEN 4 S81 1/2W 45  
1989 PAUL LAPHAM SURVEY  
FOUND 3/8" RE-STEEL OPPOSITE  
FENCE TO EAST & WEST  
WIT.-(3)FE COR POST EAST 33.23 NAIL  
(4)FE COR POST WEST 22.32 NAIL  
(5)FE POST 2ED S TO E 40.00 NAIL  
(6)FE POST 3RD N TO W COR 48.72  
(IN FILE A-5)

1978 SEDGMAN L.C.R.C.#211  
FOUND 1/2" BAR R.L.S. CAPPED  
WIT.-(7)WEST 39.26 FENCE POST  
(8)S70E 35.34 FENCE POST  
(9)S40E 53.30 FENCE POST  
(10)S15E 91.42 4" CLUMP FRUIT TREE  
1978 SEDGMAN SURVEY  
WIT.-SAME AS (7),(8),(9)&(10)  
1981 PAUL LAPHAM SURVEY  
WIT.-SAME AS (7),(8)&(9)  
1987 PAUL LAPHAM SURVEY

WIT.-SAME AS (7),(8)&(9)  
1990 PAUL LAPHAM SURVEY  
WIT.-SAME AS (7),(8)&(9)  
1993 MYERS SURVEY WIT.-NONE  
1994 PAUL LAPHAM SURVEY  
WIT.-SAME AS (7),(8)&(9)  
MISC. PAUL LAPHAM-WORKING DWGS.

B. Description of corner evidence found and/or method applied in restoring or reestablishing corner:

FOUND 3/8" X 2" AND 1/2" X 18" RODS SIDE BY SIDE 8" TO 10" BELOW SURFACE IN C/L OF COUNTY ROAD OPPOSITE FENCE TO WEST. FOUND (8), N&T, POOR CONDITION, LEANING; MEAS. 35.15, REC. 35.34. FOUND (10); MEAS. 91.5+- TO FACE OF 8" APPLE, MOST WESTERLY OF CLUMP, REC. 91.42. SET GLADWIN RE-MON IN PLACE OF FOUND IRONS.

APPROVED LAND CORNER

PAUL D. 15 of 1996  
Gladwin County


SEE DOSSIER FOR DETAILED REPORT.

Co. Rep. John Meyers  
Date 11/6/96

C. Description of monument for corner and accessories established to perpetuate locating the position of the corner:

C-6: 1/4 CORNER COMMON TO SECTIONS 17 & 18  
SET 5/8" X 36" REROD WITH GLADWIN RE-MON CAP MARKED P.S.#27458

WITNESSES:  
S75E 6" ELM, N&T, 38.24'  
S20E 4" CLUMP OF APPLE TREES, N&T, 91.60'  
S25W 6" ELM, N&T, 78.45'  
WEST 10" ELM, N&T, 69.98'

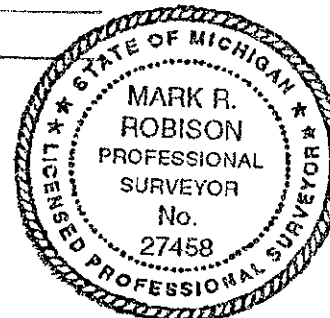

Signed by Mark R. Robison  
Surveyor's Michigan License No. 27458

Date 11-29-96