

LAND CORNER RECORDATION CERTIFICATE
Filing Requirement of Act 74, Mich. P.A. 1970

Register's Office } ss.
Gogebic County }

For corners in

Gogebic
(County)

Located In: Corner Code: 11

44/ 38 AB-13 001

T 43N R 38W AB-1e 001

T R

T R

T R

S T R

S T R

S T R

S T R

Other #1

Received for record the
3RD day of FEBRUARY

A. D. 19 93 at 10:35 o'clock

A m., and recorded in

Liber 4 of CORNERS

on page 218

Richard J. Brown, Jr.

Register of Deeds

Register of Deeds Stamp & File Number

1. Public Land Survey

2. Property Controlling
in Section

3. Miscellaneous
Property in Sec.

4. Lot No. , Recorded Plat

5. Private Claims

I, Gary L. Pisoni, in a field survey on November 12, 19 92, do hereby certify that under requirements of P.A. 74, Michigan P.A. of 1970, the corner points mentioned in lines 1 and 2 above were in conformance with regulations and rules therefore as required in the current manual of survey instructions of the United States Department of the Interior, Bureau of Land Management or by a decree of a Court of Law and/or that the corner points mentioned in lines 3, 4 and 5 above were in conformance with the rules of the Michigan Board of Land Surveyors or by a Decree of a Court of Law; established, re-established, monumented, re-monumented, recovered, found as expressed below:

NOTE: Not more than 4 corners, all in the same town and range, may be recorded on this certificate.

A. Description of original monument and accessories and/or subsequent restoration:
Original corner established by Austin Burt, U.S. Deputy Surveyor on June 8, 1847.

Original corner: Tamarack Post
Original bearing tree:
Tamarack 8" N 13° 30' E 22 links (14.52 feet)

B. Description of corner evidence found and/or method applied in restoring or reestablishing corner:
No original corner evidence found. Corner restored on line between the Northeast and Northwest Section corners of Section 6 on the East shore of Lac Vieux Desert. Said Meander Corner located 14 feet from waters edge.


PEER GROUP APPROVED
Richard L. DeBruin 1/20/94
COUNTY REPRESENTATIVE

C. Description of monument for corner and accessories established to perpetuate locating the position of the corner:
At the corner position I set a 3/4" outside diameter by 12 feet long aluminum rod monument with a 3" cast aluminum cap, stamped to read; T44N R38W; M.C.; S-31; S-6; T43N; 1992; R.L.S. 27457 from which established the following new blazed and scribed bearing trees: (all measurements taken to a nail in side of tree)

| | | | |
|-----------------|-----|---------|------------|
| Tamarack | 6" | N 50° E | 42.36 feet |
| Tamarack | 11" | S 23° E | 29.23 feet |
| Steel Sign Post | | North | 0.95 feet |
| Steel Sign Post | | East | 0.95 feet |

igned by Gary L. Pisoni Date 1/28/93

Surveyor's Michigan License No. 27457

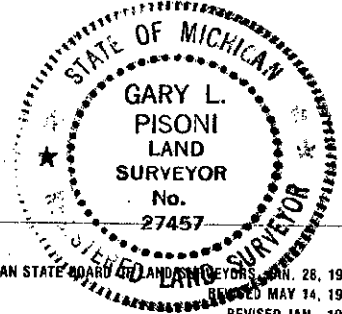

U.S.F.S. A-2,3