

SURVEY & REMONUMENTATION

JAN 22 1998

LAND CORNER RECORDATION CERTIFICATE
Filing Requirement of Act 74, Mich. P.A. 1970

Register's Office } ss.
Gogebic County }

For corners in SECTION
Gogebic

Located In:

Corner Code #

1. Public Land Survey

Section 13 44W 39W K/L 7W

T R
T R
T R
T R
S T R
S T R
S T R
S T R

006

2. Property Controlling
in Section

3. Miscellaneous
Property in Sec.

Received for record the
24TH day of NOVEMBER
A. D. 1997 at 11:40 o'clock
A. m., and recorded in
Liber 6 of CORNERS
on page 265
Ramona Collins, Deputy
Register of Deeds

Register of Deeds Stamp & File Number

4. Lot No. Recorded Plat

5. Private Claims
M.C. on west bay on north side of Dinner Lake between
Sections 13 & 24, T44N, R39W.

I, John R. Garske, in a field survey on October 13, 1997 do hereby state that under requirements of P.A. 74, Michigan P.A. of 1970, the corner points mentioned in lines 1 and 2 above were in conformance with regulations and rules therefore as required in the current manual of survey instructions of the United States Department of the Interior, Bureau of Land Management or by a decree of a Court of Law and/or that the corner points mentioned in lines 3, 4 and 5 above were in conformance with the rules of the Michigan Board of Land Surveyors or by a Decree of a Court of Law; established, re-established, monumented, recovered, found as expressed below:

NOTE: Not more than 2 corners, all in the same town and range, may be recorded on this certificate.

	A	B	C	D	E	F	G	H	I	J	K	L	M
1													
2	6		5		4		3		2		1		
3													
4	7		8		9		10		11		12		
5													
6	10		17		16		15		14		13		
7													
8	19		20		21		22		23		24		
9													
10	30		29		28		27		26		25		
11													
12	31		32		33		34		35		36		
13													

A. Description of original monument and accessories and/or subsequent restoration:

Original corner set by Wells Burt, D.S. in 1851, from which:

Hemlock 10" N10°W 11 links

W. Pine 10" S75°N 16 links

1961 - Donald Lappala RLS 12585 monumented the corner from the remains of the White Pine bearing tree. He set a 2" x 5' long gal. pipe with a 3" brass cap stamped to identify the corner from which he established:

18" Hemlock N15°E 22.6 feet

7" Hemlock N76°W 15.4 feet

4" x 4" Cedar post North 3.1 feet

2" x 48" iron pipe N28°E 14.0 feet


(Corner recorded L1, pg. 28)

B. Description of corner evidence found and/or method applied in restoring or reestablishing corner:

I found the brass capped pipe set by Lappala in 1961 in good condition approximately 2 feet from shore in the lake. I also found a steel sign rail noting the corner position. The iron pipe is gone, replaced with a 3" x 3" cedar post as noted by USFS surveyor Richard Drahn during corner maintenance in 1985.

(Research on file)

PEER GROUP APPROVED
Richard L. Drahn 11/11/97
COUNTY REPRESENTATIVE

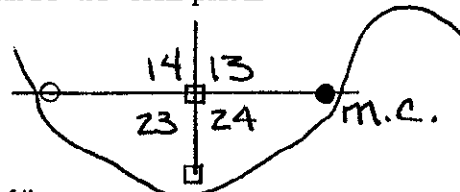

C. Description of monument for corner and accessories established to perpetuate locating the position of the corner:

I found the brass capped pipe set by Lappala and established the following accessories:

11" Hemlock N76°W 15.43 feet (existing)

3" x 3" Cedar Post N28°E 14.00 feet (existing)

4" x 4" Cedar Post North 3.10 feet (existing)

Steel Sign Rail NELY 0.67 feet (existing)



Signed by John R. Garske

Date 11/11/97

Surveyor's Michigan License No. 28410