

14
Register's Office }
Gogebic County } ss.

LAND CORNER RECORDATION CERTIFICATE
Filing Requirement of Act 74, Mich. P.A. 1970

For corners in

Gogebic
(County)

Located In:

Corner Code #1

1. Public Land Survey

T46N R40W

B-1.2W

T R

004

T R

T46N R40W

ONT. COUNTY

2. Property Controlling
in Section

S T R

S T R

3. Miscellaneous

S T R

Property in Sec.

S T R

4. Lot No. , Recorded Plat

5. Private Claims

38.96 CHS. WEST

I, Gary L. Pisoni, in a field survey on March 29, 1991, do hereby certify that under requirements of P.A. 74, Michigan P.A. of 1970, the corner points mentioned in lines 1 and 2 above were in conformance with regulations and rules therefore as required in the current manual of survey instructions of the United States Department of the Interior, Bureau of Land Management or by a decree of a Court of Law and/or that the corner points mentioned in lines 3, 4 and 5 above were in conformance with the rules of the Michigan Board of Land Surveyors or by a Decree of a Court of Law; established, re-established, monumented, re-monumented, recovered, found as expressed below:

NOTE: Not more than 4 corners, all in the same town and range, may be recorded on this certificate.

A. Description of original monument and accessories and/or subsequent restoration:

Original corner established by John Burt, U.S. Deputy Surveyor in July 9, 1847.

Original corner: Meander post

Original bearing trees:

Yellow Pine	10"	N 25° E	25 links (16.50 feet)
Fir	8"	S 23° E	9 links (5.94 feet)

B. Description of corner evidence found and/or method applied in restoring or reestablishing corner:

No original corner evidence found. Corner restored by single proportionate measurement methods on line between the Northwest corner of Section 6, T45N, R40W, and the East meander corner between Sections 32 and 5.

C. Description of monument for corner and accessories established to perpetuate locating the position of the corner:

At the corner position, I set a standard 2" diameter by 30" long split base aluminum pipe monument with a 3" cast aluminum cap, stamped to read: T46N, R40W, M.C., S-31, S-6, T45N, 1991, R.L.S. 27457; from which I established the following new blazed and scribed bearing trees: (all measurements taken to a nail in side of tree) 6' from waters edge.

Red Pine	11"	N 05° E	25.19 feet
Red Pine	8"	S 64° E	10.12 feet
Red Pine	7"	S 40° E	4.29 feet
Steel sign post		East	0.87 feet

Received for record the
11th day of AUGUST

A. D. 1992 at 9:15 o'clock

A. m., and recorded in

Liber 4 of CORNERS

on page 247

Betty L. Larkin, Deputy
Register of Deeds

Register of Deeds Stamp & File Number

	A	B	C	D	E	F	G	H	I	J	K	L	M
2	6	5	4	3	2	1							
3													
4	7	8	9	10	11	12							
5													
6	18	17	16	15	14	13							
7													
8	19	20	21	22	23	24							
9													
10	30	29	28	27	26	25							
11													
12	31	32	33	34	35	36							
13													


PEER GROUP APPROVED

Richard L. Deane 1/25/94
COUNTY REPRESENTATIVE

C. Description of monument for corner and accessories established to perpetuate locating the position of the corner:

At the corner position, I set a standard 2" diameter by 30" long split base aluminum pipe monument with a 3" cast aluminum cap, stamped to read: T46N, R40W, M.C., S-31, S-6, T45N, 1991, R.L.S. 27457; from which I established the following new blazed and scribed bearing trees: (all measurements taken to a nail in side of tree) 6' from waters edge.

Red Pine	11"	N 05° E	25.19 feet
Red Pine	8"	S 64° E	10.12 feet
Red Pine	7"	S 40° E	4.29 feet
Steel sign post		East	0.87 feet

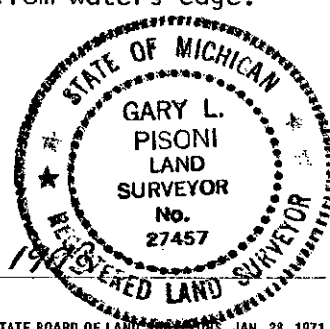

Signed by Gary L. Pisoni

Date August 6th, 1992

Surveyor's Michigan License No. 27457

U.S.F.S. #A-3,4w(East side of East Bay)

247