

REMOVED
MAY 16 1987
COMMISSION

LAND CORNER RECORDATION CERTIFICATE
Filing Requirement of Act 74, Mich. P.A. 1970

Register's Office } ss.
Gogebic County }

For corners in Gogebic Located In: _____ Corner Code # _____
(County)

Received for record the
17TH day of OCTOBER
A. D. 1996 at 9:50 o'clock
A m., and recorded in
Liber 6 of CORNERS
on page 64
Ramona Collim, Deputy
Register of Deeds

1. Public Land Survey Section 19 T 45N R 41W A-8
T 45N R 42W M-8
T _____ R _____
T _____ R _____
2. Property Controlling S _____ T _____ R _____
in Section S _____ T _____ R _____
3. Miscellaneous S _____ T _____ R _____
Property in Section S _____ T _____ R _____

Register of Deeds Stamp & File Number

4. Lot No. _____, Recorded Plat _____
5. Private Claims _____

The one-quarter corner common to Sections 19, 24, T45N, R42-41W.

I, John R. Garske, in a field survey on September 24, 19 96,
do hereby certify that under requirements of P.A. 74, Michigan P.A. of 1970, the corner points mentioned
in lines 1 and 2 above were in conformance with regulations and rules therefore as required in the current
manual of survey instructions of the United States Department of the Interior, Bureau of Land
Management or by a decree of a Court of Law and/or that the corner points mentioned in lines 3, 4 and
5 above were in conformance with the rules of the Michigan Board of Professional Surveyors or by a
Decree of a Court of Law; established, re-established, monumented, re-monumented, recovered, found
as expressed below:

A	B	C	D	E	F	G	H	I	J	K	L	M
2	6	5	4	3	2	1						
3												
4	7	8	9	10	11	12						
5												
6	18	17	16	15	14	13						
7												
8	19	20	21	22	23	24						
9												
10	30	29	28	27	26	25						
11												
12	31	32	33	34	35	36						
13												

NOTE: Not more than 4 corners, all in the same town and range, may be recorded
on this certificate.

A. Description of original monument and accessories and/or subsequent restoration:

In 1844, William Burt, U.S. Deputy Surveyor, set a wooden post and the following bearing trees:
36" White Pine - N25°E - 44 links
9" Yellow birch - N20°W - 9 links

In 1974, Richard Drahn, R.I.S., set a 2 1/2" pipe with a brass tablet and established the following bearing trees and
reference objects:
7" White spruce - N24°E - 18.3 feet 4" x 4" x 7' cedar sign post - S80°W - 2.6 feet
9" White spruce - S45°E - 22.6 feet 3" sugar maple - S89°W - 53.5 feet

B. Description of corner evidence found and/or method applied in restoring or reestablishing corner:

I found the iron pipe with brass tablet. Two bearing trees were still existing as was the cedar sign post. I updated
the corner position to State and County specifications as noted below.


P.A. 74 research on file.

PEER GROUP APPROVED
Richard L. Drahn 10/16/96
COUNTY REPRESENTATIVE

C. Description of monument for corner and accessories established to perpetuate locating the position of the corner:

I established or updated the following bearing trees and reference objects:
7" maple - West - 53.55 feet (existing)
12" spruce - N28°E - 18.17 feet (existing)
14" spruce - S25°W - 18.63 feet (new)
6' steel sign rail - east - 1.09' (new)

All bearing trees were blazed, painted, scribed and tagged.

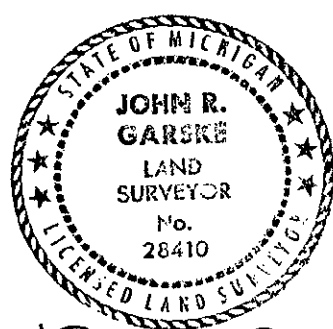

Signed by John R. Garske Date 10-15-96
Surveyor's Michigan License No. 28410

FORM APPROVED BY MICHIGAN STATE BOARD OF PROFESSIONAL SURVEYORS, JAN. 28, 1971
REVISED MAY 14, 1976
REVISED JAN., 1983