

SURVEY & REMONUMENTATION

JAN 22 1998

SECTION

LAND CORNER RECORDATION CERTIFICATE Filing Requirement of Act 74, Mich. P.A. 1970

Register's Office }
Gogebic County } ss.

For corners in

Gogebic

Located In:

Corner Code #

(County)

1. Public Land Survey Section 32 45W 43W D-11-12
 T R _____
 T R 004
 T R _____
 T R _____
 T R _____
 2. Property Controlling S T R _____
 in Section S T R _____
 3. Miscellaneous S T R _____
 Property in Sec. S T R _____

Received for record the
24th day of November
 A. D. 1997 at 11:40 o'clock
A m., and recorded in
 Liber 6 of CORNEL
 on page 266
Ramona Collins, Deputy
 Register of Deeds

Register of Deeds Stamp & File Number

4. Lot No. _____, Recorded Plat _____

5. Private Claims _____

Mile Post No. 20 + 1670.00 on MI/WI state line.

John R. Garske

October 20, 97

I, _____, in a field survey on _____, 19____ do hereby state that under requirements of P.A. 74, Michigan P.A. of 1970, the corner points mentioned in lines 1 and 2 above were in conformance with regulations and rules therefore as required in the current manual of survey instructions of the United States Department of the Interior, Bureau of Land Management or by a decree of a Court of Law and/or that the corner points mentioned in lines 3, 4 and 5 above were in conformance with the rules of the Michigan Board of Land Surveyors or by a Decree of a Court of Law; established, re-established, monumented, recovered, found as expressed below:

NOTE: Not more than 2 corners, all in the same town and range, may be recorded on this certificate.

	A	B	C	D	E	F	G	H	I	J	K	L	M
1													
2	6			5			4			3		2	1
3													
4	7			8			9			10		11	12
5													
6	18			17			16			15		14	13
7													
8	19			20			21			22		23	24
9													
10	30			29			28			27		26	25
11													
12	31			32			33			34		35	36
13													

A. Description of original monument and accessories and/or subsequent restoration:

State line meander corner established by William Burt, D.S., in 1847. - Bearing tree: 11" W. Pine - N53°E - 16.5 feet.
 1928 - Mile corner 20+1670.0 reestablished by Harrington a U.S. Cadastral Surveyor in Joint Boundary Survey for Mich. & Wis.. He reestablished the corner from the original N.E. B.T., No new B.T.'s set.
 1974 - Robert Winat RLS 20585 shows Mile Post 20+1670.0 on a survey with B.T. - 12" cedar - N21°W - 9.0 feet.

B. Description of corner evidence found and/or method applied in restoring or reestablishing corner:

I found a 6"x6" concrete monument approximately 3 feet out into the lake from shore in 1' ± of water protruding 6" ± above the water. A metal tablet on the monument is stamped: Mile corner No. 20+1670.0; Michigan, 1847 state - line 1928; Wisconsin; JOINT BOUNDARY COMMISSION. All bearing trees have been destroyed. I updated the corner to state and county specifications below. (Research on file)


PEER GROUP APPROVED

Richard D. Dredman 11/11/97
 COUNTY REPRESENTATIVE

C. Description of monument for corner and accessories established to perpetuate locating the position of the corner:

Found monument described above from which I established the following bearing trees or objects:

10" Cedar	N14°W	13.13 feet
8" Sugar	S80°E	14.60 feet
10" Sugar	N35°E	16.75 feet
Steel Sign Rail	N55°E	2.43 feet

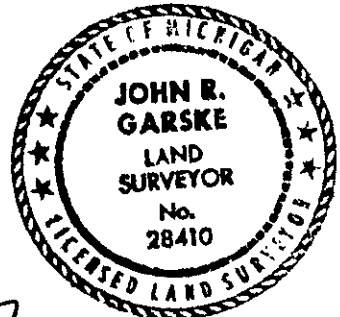

Signed by

John R. Garske
 Surveyor's Michigan License No. 28410

Date

11/11/97