

# SURVEY & MONUMENTATION

AUG 08 1997

COMMISSION

## LAND CORNER RECORDATION CERTIFICATE Filing Requirement of Act 74, Mich. P.A. 1970

Register's Office  
Gogebic County } ss.

For corners in

Gogebic  
(County)

Located in:

Corner Code --#

1. Public Land Survey

T45N. R 45W.

E-5-6

T R

T R

T R

T R

2. Property Controlling  
in Section

S T R

S T R

3. Miscellaneous

S T R

Property in Sec.

S T R

4. Lot No. , Recorded Plat

5. Private Claims

Closing Corner, Secs. 16 & 17 on Mich. Wisc. line

I, Richard L. Drahn, in a field survey on May 5, 19 97,  
do hereby certify that under requirements of P.A. 74, Michigan P.A. of 1970, the corner points mentioned  
in lines 1 and 2 above were in conformance with regulations and rules therefore as required in the  
current manual of survey instructions of the United States Department of the Interior, Bureau of Land  
Management or by a decree of a Court of Law and/or that the corner points mentioned in lines 3, 4 and 5  
above were in conformance with the rules of the Michigan Board of Land Surveyors or by a Decree of a  
Court of Law; established, re-established, monumented, re-monumented, recovered, found as  
expressed below:

**NOTE: Not more than 4 corners, all in the same town and range, may be recorded  
on this certificate.**

A. Description of original monument and accessories and/or subsequent restoration:

Corner established by Austin Burt on August 8, 1851. Original B.T.s --- 10"  
Spruce N.50 E. 14 links (9.24') --- 6" Spruce N.41 W. 16 links (10.56') ---

Corner position re-established by Bill Stuth, Wisc. Surveyor in 1984 by a  
survey along the State Line. His mathematical corner position was marked by  
a Cedar post.

B. Description of corner evidence found and/or method applied in restoring or reestablishing corner:

Restored corner position from the badly decayed stump of Burt's 1851 NE  
bearing tree. No evidence remains of his NW B.T. The Cedar post set in 1984  
by Bill Stuth bears N.70 E. 0.4 feet from the original corner location.

Research form on file with Gogebic County records.


PEER GROUP APPROVED

Richard L. Drahn 5/12/97  
COUNTY REPRESENTATIVE

C. Description of monument for corner and accessories established to perpetuate locating the position of the corner:

At the corner location I set a 2" by 30" alum. monument with a 3 1/4" alum.  
cap stamped to indicate the corner designation. From the monument I  
established the following new bearing objects:

9"	Yellow Birch	N.26 W.	38.48 ft.
5"	Red Maple	N.71 E.	30.49 ft.
6"	Sugar Maple	S.40 W.	16.30 ft.
6'	Steel sign rail	North	2.86 ft.

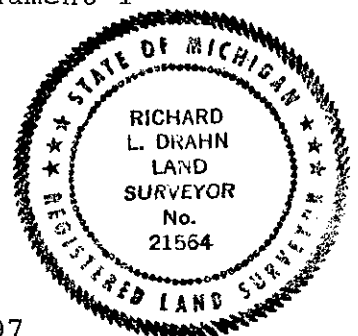

Signed by Richard L. Drahn

Date May 8, 1997

Surveyor's Michigan License No. 21564

