

**SURVEY &
REMONUMENTATION**

NOV 12 1997

COMMISSION

LAND CORNER RECORDATION CERTIFICATE
Filing Requirement of Act 74, Mich. P.A. 1970

For corners in

Gogebic

(County)

Located In:

Corner Code #

1. Public Land Survey

Section 2 45N 45W

I-J-3

T___ R___
T___ R___
T___ R___
T___ R___

Other
012

2. Property Controlling
in Section

S___ T___ R___
S___ T___ R___

3. Miscellaneous
Property in Sec.

S___ T___ R___
S___ T___ R___

4. Lot No. _____, Recorded Plat _____
5. Private Claims _____

Meander corner to sections 2 and 11, T45N, R45W

I, John R. Garske, in a field survey on Sept. 9, 1997 do hereby state that under requirements of P.A. 74, Michigan P.A. of 1970, the corner points mentioned in lines 1 and 2 above were in conformance with regulations and rules therefore as required in the current manual of survey instructions of the United States Department of the Interior, Bureau of Land Management or by a decree of a Court of Law and /or that the corner points mentioned in lines 3, 4 and 5 above were in conformance with the rules of the Michigan Board of Land Surveyors or by a Decree of a Court of Law; established, re-established, monumented, recovered, found as expressed below:

NOTE: Not more than 2 corners, all in the same town and range, may be recorded on this certificate.

A. Description of original monument and accessories and/or subsequent restoration:

Original survey by Austin Burt, D.S. in 1851
intersect Lake at 65.55 ch. from which a:
Cedar 14" Meander corner and
Fir 8" S50°E - 24 links

B. Description of corner evidence found and/or method applied in restoring or reestablishing corner:

I monumented the corner at a found wooden post set along a blue line on the east shore of Chaney lake. This corner location is consistent with GLO natural feature ties and appears to be in the logical location with occupation lines which are in harmony. Keeweenaw lands has been using this location for over 40 years. No evidence of the original bearing trees exists with the wood post being the best available evidence to monument the corner.

(Research on file)


C. Description of monument for corner and accessories established to perpetuate locating the position of the corner:

I set 3/4" dia. x 48" alum. rod with a 3 1/4" dia alum. cap stamped to identify the corner; from which I established the following:

Cedar 12"	N43°E	14.60 feet
Sugar 12"	S82°E	31.89 feet
Sugar 6"	S15°E	12.14 feet
Hemlock 7"	S15°E	12.14 feet
Steel sign rail	north	0.51 feet
3'± east of water's edge		

Signed by John R. Garske
Surveyor's Michigan License No. 28410

Date 10/8/97

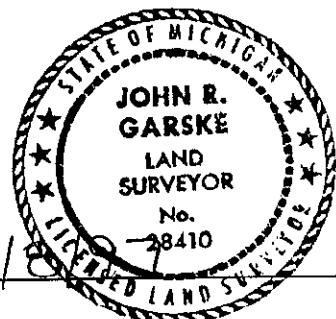

Register's Office
Gogebic County } ss.

Received for record the
9TH day of OCTOBER
A. D. 1997 at 11:00 o'clock
A m., and recorded in
Liber 6 of CORNERS

page 237
Pamela Collins, Deputy
Register of Deeds

Register of Deeds Stamp & File Number

	A	B	C	D	E	F	G	H	I	J	K	L	M
1													
2	6		5		4		3		2		1		
3													
4	7		8		9		10		11		12		
5													
6	18		17		16		15		14		13		
7													
8	19		20		21		22		23		24		
9													
10	30		29		28		27		26		25		
11													
12	31		32		33		34		35		36		
13													