

SURVEY & REMONUMENTATION

AUG 08 1997

COMMISSION

LAND CORNER RECORDATION CERTIFICATE Filing Requirement of Act 74, Mich. P.A. 1970

For corners in

Gogebic
(County)

Located In:

Corner Code #

1. Public Land Survey

T45N R 45 W A-3-4
T R 011
T45N R 46 W M-3-4
T R 006

2. Property Controlling
in Section

S T R
S T R

3. Miscellaneous
Property in Sec.

S T R
S T R

4. Lot No. , Recorded Plat

5. Private Claims

Closing Corner, Secs. 7 & 12 on Mich.---Wisc. State Line

I, Richard L. Drahn in a field survey on June 5, 19 97, do hereby certify that under requirements of P.A. 74, Michigan P.A. of 1970, the corner points mentioned in lines 1 and 2 above were in conformance with regulations and rules therefore as required in the current manual of survey instructions of the United States Department of the Interior, Bureau of Land Management or by a decree of a Court of Law and/or that the corner points mentioned in lines 3, 4 and 5 above were in conformance with the rules of the Michigan Board of Land Surveyors or by a Decree of a Court of Law; established, re-established, monumented, re-monumented, recovered, found as expressed below:

NOTE: Not more than 4 corners, all in the same town and range, may be recorded on this certificate.

A. Description of original monument and accessories and/or subsequent restoration:

Corner established by William A. Burt on August 30, 1847. Original B.T.s --- Y. Birch 18" N.41 W. 62 links (40.92') --- Hemlock 22" N.85 E. 17 links (11.22') ---

Corner positioned 0.85 chains N.74 W. from Mile Corner #6½.

Research form on file with Gogebic County records.

B. Description of corner evidence found and/or method applied in restoring or reestablishing corner:

Restored corner position at record bearing and distance from the remains of the two original bearing trees. The first is a 24-30" Yellow Birch stump decayed to ground line. The second one is now a very large wind-thrown stump hole. The 0.85 chain distance SE along the State Line is in accordance with the field notes of the original survey to Mile Corner #6½.

C. Description of monument for corner and accessories established to perpetuate locating the position of the corner:


At the corner position I set a 2½" X 30" aluminum pipe with a ¾" aluminum cap stamped to indicate the corner and the following new B.T.s.

5"	Sugar Maple	N.18 W.	6.71 ft.
8"	Sugar Maple	N.69 E.	13.55 ft.
4"	Sugar Maple	S.31 E.	9.50 ft.
6'	Steel sign rail	N.04 E.	1.52 ft.

Register's Office }
Gogebic County }

Received for record the
11TH day of JUNE
A. D. 1997 at 10:45 o'clock
A. M., and recorded in
Liber 6 of CORNERS
on page 155
Colleen M. Kibler, Deputy
Register of Deeds

Register of Deeds Stamp & File Number

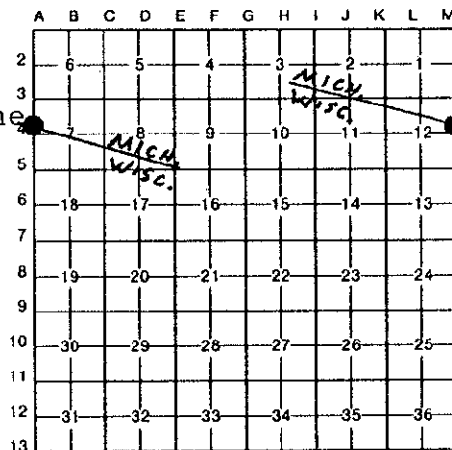

PEER GROUP APPROVED
Richard L. Drahn 6/10/97
COUNTY REPRESENTATIVE



Signed by Richard L. Drahn

Date June 7, 1997

Surveyor's Michigan License No. 21564