

# SURVEY & REMONUMENTATION

NOV 12 1997

COMMISSION

## LAND CORNER RECORDATION CERTIFICATE Filing Requirement of Act 74, Mich. P.A. 1970

For corners in

Gogebic  
(County)

Located In:

Corner Code #

- |                                    |                           |              |
|------------------------------------|---------------------------|--------------|
| 1. Public Land Survey              | T <u>45N</u> R <u>46W</u> | <u>C 1-2</u> |
|                                    | T _____ R _____           |              |
|                                    | T _____ R _____           | <u>014</u>   |
|                                    | T _____ R _____           |              |
| 2. Property Controlling in Section | S _____ T _____ R _____   |              |
|                                    | S _____ T _____ R _____   |              |
| 3. Miscellaneous Property in Sec.  | S _____ T _____ R _____   |              |
|                                    | S _____ T _____ R _____   |              |

4. Lot No. \_\_\_\_\_, Recorded Plat \_\_\_\_\_  
5. Private Claims \_\_\_\_\_

Closing Corner Sec's 5 & 6; T.45 N., R.46 W. on Line \_\_\_\_\_ State \_\_\_\_\_

I, Richard L. Drahn in a field survey on October 2, 19 97, do hereby certify that under requirements of P.A. 74, Michigan P.A. of 1970, the corner points mentioned in lines 1 and 2 above were in conformance with regulations and rules therefore as required in the current manual of survey instructions of the United States Department of the Interior, Bureau of Land Management or by a decree of a Court of Law and/or that the corner points mentioned in lines 3, 4 and 5 above were in conformance with the rules of the Michigan Board of Land Surveyors or by a Decree of a Court of Law; established, re-established, monumented, re-monumented, recovered, found as expressed below:

**NOTE:** Not more than 4 corners, all in the same town and range, may be recorded on this certificate.

### A. Description of original monument and accessories and/or subsequent restoration:

Corner established by Austin Burt on June 23, 1851. Original B.T.s --- Hemlock 18" N.39 W. 57 links (37.62') --- Y. Birch 14" N.30 E. 43 links (28.38') ---

No lateral tie provided in the original notes to a State Line Mile Corner.

### B. Description of corner evidence found and/or method applied in restoring or reestablishing corner:

Restored corner position at record distance from the recovered section corner of sec's 5, 6, 31 & 32 and record bearing and distance from the remains of the two original bearing trees. Both B.T.s were decayed to well below ground line and identified by both bark and wood fragments.

Research form on file with Gogebic County records.

### C. Description of monument for corner and accessories established to perpetuate locating the position of the corner:

At the corner position I set a 2" X 30" aluminum pipe with a 3 1/4" aluminum cap stamped to indicate the corner position and the following new B.T.s

- |     |                 |         |        |
|-----|-----------------|---------|--------|
| 7"  | Sugar Maple     | N.42 W. | 21.38' |
| 15" | Hemlock         | N.22 E. | 48.71' |
| 8"  | Red Maple       | N.80 E. | 33.89' |
| 6'  | Steel sign rail | N.10 W. | 2.47'  |

Signed by Richard L. Drahn

Date October 6, 1997

Surveyor's Michigan License No. 21564

USFS AB-5

226

Register's Office }  
Gogebic County } ss.

Received for record the  
9th day of OCTOBER

A. D. 19 97 at 10:50 o'clock


A m., and recorded in

Lib. 6 of CORNER

on page 226

Ramona Collins, Deputy  
Register of Deeds

Register of Deeds Stamp & File Number

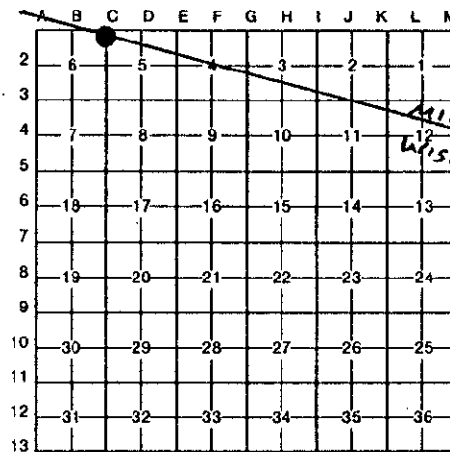

PEER GROUP APPROVED

Richard L. Drahn 10/6/97  
COUNTY REPRESENTATIVE

