SURVEY & REMONUMENTATION

JUN 2 9 1995

Property in Sec.

COMMISSION

LAND CORNER RECORDATION CERTIFICATE Filing Requirement of Act 74, Mich. P.A. 1970

Gogebio		ived		r sa	ord
25	12				
A. D. 3					
A		n., a	nd	ruco	Ne
Liber_	5		_0£_	6	KA
ou pas					

Register's Office)

For corners in Gogebic Located In: Corner Code ## T 46N R 42W E-6 Public Land Survey T _____ R __ _ R ___ R _ T ____ R _ **Property Controlling** in Section __ T ____ R ___ ___ T ____ R _ Miscellaneous

Register of Deeds Stamp & File Number


Register of Beeck

4.	Lot No, Recorded Plat
5.	Private Claims
	1/4 Corner Sections 16 & 17; T.46N., R.42W.

I. Richard I. Drahn. in a field survey on July 7, 19 94. do hereby certify that under requirements of P.A. 74, Michigan P.A. of 1970, the corner points mentioned in lines 1 and 2 above were in conformance with regulations and rules therefore as required in the current manual of survey instructions of the United States Department of the Interior, Bureau of Land Management or by a decree of a Court of Law and/or that the corner points mentioned in lines 3, 4 and 5 above were in conformance with the rules of the Michigan Board of Land Surveyors or by a Decree of a Court of Law; established, re-established, monumented, re-monumented, recovered, found as expressed below:

NOTE: Not more than 4 corners, all in the same town and range, may be recorded on this certificate.

A. Description of original monument and accessories and/or subsequent restoration:

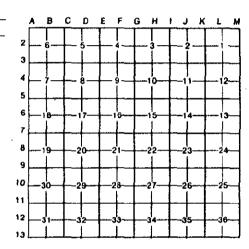


Corner established by A. Merryweather, U.S. Deputy Surveyor, on August 16, 1851. Original bearing trees:

Hemlock 30" N.50W 10 links (6.60 feet)
Lynn 5" S.38E. 11 links (7.26 feet)

B. Description of corner evidence found and/or method applied in restoring or reestablishing corner:

No G.L.O. remains. Re-established corner position on line between and equal distance from the northeast and southeast section corners of Section 17, T.46N., R.42W.

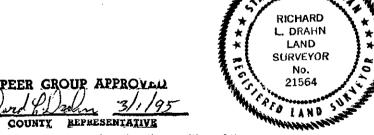

REVISED MAY 14, 1975 REVISED JAN., 1983

C. Description of monument for corner and accessories established to perpetuate locating the position of the corner: At the corner position I set a 2 1/2 " diameter by 30" long aluminum monument with a 3 1/4" aluminum cap with magnet stamped to read: T.46N., R.42W.; 1/4; S-16, S-17; 1994; R.L.S. 21564 from which I established the following new blazed and scribed bearing trees and/or objects:

19" Cedar N.15W.	31.25 feet
15 00441 11571	
13" Sugar Maple N.62E.	27.62 feet
13" Spruce S.15E.	6.99 feet
6' Steel Rail S.51E.	2.15 feet

Signed by Richard L. Wrahn Date	February 6, 1995
Surveyor's Michigan License No. 21564	FORM APPROVED BY MICHIGAN STATE BOARD OF LAND SURVEYORS, JAN. 28, 1971