

LAND CORNER RECORDATION CERTIFICATE
Filing Requirement of Act 74, Mich. P.A. 1970

Register's Office }
 Gogebic County } ss.

For corners in

Gogebic
 (County)

Located In:

Corner Code #

1. Public Land Survey

T46 N R44 W.

D-5

T R

SURVEY &

T R

REMONUMENTATION

T R

2. Property Controlling
 in Section

S T R

JAN 05 2001

S T R

3. Miscellaneous
 Property in Sec.

S T R

SECTION

Received for record the
26th day of MAY

A. D. 1900 at 10:40 o'clock

A m., and recorded in

Liber 7 of CORNERS

on page 288

Cheryl Ruppel
 Dep. Register of Deeds

Register of Deeds Stamp & File Number

4. Lot No. , Recorded Plat

5. Private Claims

1/4 Corner 8 & 17; T.46 N., R.44 W.

I, Richard L. Drahn, in a field survey on May 10, 2000 do hereby state that under requirements of P.A. 74, Michigan P.A. of 1970, the corner points mentioned in lines 1 and 2 above were in conformance with regulations and rules therefore as required in the current manual of survey instructions of the United States Department of the Interior, Bureau of Land Management or by a decree of a Court of Law and /or that the corner points mentioned in lines 3, 4 and 5 above were in conformance with the rules of the Michigan Board of Land Surveyors or by a Decree of a Court of Law; established, re-established, monumented, recovered, found as expressed below:

NOTE: Not more than 2 corners, all in the same town and range, may be recorded on this certificate.

| | A | B | C | D | E | F | G | H | I | J | K | L | M |
|----|---|----|---|----|---|----|---|----|---|----|---|----|---|
| 1 | | | | | | | | | | | | | |
| 2 | | 6 | | 5 | | 4 | | 3 | | 2 | | 1 | |
| 3 | | | | | | | | | | | | | |
| 4 | | 7 | | 8 | | 9 | | 10 | | 11 | | 12 | |
| 5 | | | | | | | | | | | | | |
| 6 | | 18 | | 17 | | 16 | | 15 | | 14 | | 13 | |
| 7 | | | | | | | | | | | | | |
| 8 | | 19 | | 20 | | 21 | | 22 | | 23 | | 24 | |
| 9 | | | | | | | | | | | | | |
| 10 | | 30 | | 29 | | 28 | | 27 | | 26 | | 25 | |
| 11 | | | | | | | | | | | | | |
| 12 | | 31 | | 32 | | 33 | | 34 | | 35 | | 36 | |
| 13 | | | | | | | | | | | | | |

A. Description of original monument and accessories and/or subsequent restoration:

Original corner established by Austin Burt on 8/22/1851. Original bearing trees:

| | | | | |
|-------|-----|----------|----------|----------|
| Maple | 14" | S.44° W. | 03 links | (1.98') |
| Sugar | 6" | N.59° E. | 41 links | (27.06') |

B. Description of corner evidence found and/or method applied in restoring or reestablishing corner:

Corner research on file with Gogebic County records.


Restored the corner position at record bearing and distance from the remains of the two original bearing trees. The first is large series of root holes with fragments of hardwood (species undetermined). The second one is now a deep stump hole with fragments of badly decayed Sugar Maple wood in the root holes.

C. Description of monument for corner and accessories established to perpetuate locating the position of the corner:

At the corner position I set a 2" x 30" aluminum pipe monument with a 3 1/4" stamped aluminum cap and the Following new B.T.s (all measurements taken to a nail in side of tree):

| | | | |
|-----------------|-----|----------|--------|
| Red Maple | 9" | N.06° E. | 24.93' |
| Sugar Maple | 13' | S.66° E. | 9.99' |
| Hemlock | 17" | S.63° W. | 16.65' |
| Steel sign rail | 6' | N.84° W. | 1.56' |

PEER GROUP APPROVED
Richard L. Drahn 05/24/00
COUNTY REGISTER

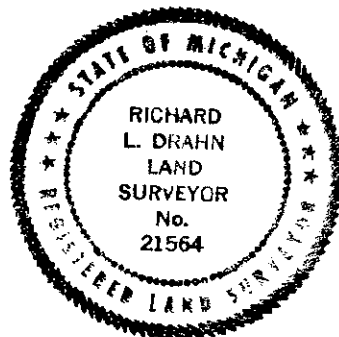

Signed by Richard L. Drahn Date May 12, 2000

Surveyor's Michigan License No. 21564

FORM APPROVED BY MICHIGAN STATE BOARD OF PROFESSIONAL SURVEYORS, JAN. 29, 1971
 REVISED MAY 14, 1975
 REVISED JAN., 1983
 REVISED OCT., 1995