

LAND CORNER RECORDATION CERTIFICATE  
Filing Requirement of Act 74, Mich. P.A. 1970

For corners in

Gogebic  
(County) Located In: Corner Code #

1. Public Land Survey S-36 T 47N R 47W L-13  
T R  
T R  
T 46N R 47W L-1

2. Property Controlling S T R  
in Section S T R

3. Miscellaneous S T R  
Property in Sec. S T R

Register's Office }  
Gogebic County } ss.

Received for record the  
12<sup>th</sup> day of APRIL  
A. D. 1995 at 1:15 o'clock  
P. M., and recorded in  
Lib. 5 of CORNER  
on page 238  
Ramona Collins, Deputy  
Register of Deeds

Register of Deeds Stamp & File Number

4. Lot No. , Recorded Plat  
5. Private Claims  
One-quarter corner common to Section 36, T47N, R47W  
and Section 1, T46N, R47W.

I, John R. Garske, in a field survey on March 30, 19 95,  
do hereby certify that under requirements of P.A. 74, Michigan P.A. of 1970, the corner points mentioned  
in lines 1 and 2 above were in conformance with regulations and rules theretofore as required in the  
current manual of survey instructions of the United States Department of the Interior, Bureau of Land  
Management or by a decree of a Court of Law and/or that the corner points mentioned in lines 3, 4 and 5  
above were in conformance with the rules of the Michigan Board of Land Surveyors or by a Decree of a  
Court of Law; established, re-established, monumented, re-monumented, recovered, found as  
expressed below:

**NOTE: Not more than 4 corners, all in the same town and range, may be recorded  
on this certificate.**

A. Description of original monument and accessories and/or subsequent restoration:

On September 6, 1847, William Austin Burt set a sugar post from which a 10" Y. birch bears N06°W, 12 links and a 6" sugar -  
N11°E, 24 links.

B. Description of corner evidence found and/or method applied in restoring or reestablishing corner:

No original evidence could be found due to road and utility construction, logging and farming. I reestablished the corner position by  
single proportionate measurement. The corner is set on township line and midway between the section corner common to Sections  
36, 31, 1 and 6, and the section corner common to Sections 35, 36, 1 and 2. The corner location is in harmony with occupation  
lines to the north and to the south.

Record research on file with Register of Deeds.


PEER GROUP APPROVED

Richard L. Drolen 4/6/95  
COUNTY REPRESENTATIVE

C. Description of monument for corner and accessories established to perpetuate locating the position of the corner:

I set a 2 1/2" diameter x 30" long aluminum pipe with a 3 1/4" diameter cap at the corner position. The cap is stamped: County  
Remonumentation; 1/4 cor.; T47N, T46N, R47W; S-36; S-1; 1995; RLS 28410, from which I established the following bearing  
trees and/or reference objects:

10" R. pine - N42°E, 39.74 feet  
Power pole - S29°E, 65.26 feet  
Clump of 4 - 4" R. maple - S69°W, 18.66 feet  
6 foot steel rail with sign - N47°W, 1.75 feet

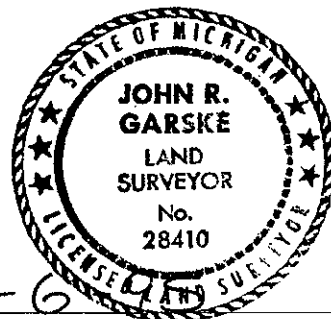

Signed by John R. Garske Date 4-6  
Surveyor's Michigan License No. 28410

Fed. No. Z-23