

NOV 12 1997

COMMISSION

LAND CORNER RECORDATION CERTIFICATE
Filing Requirement of Act 74, Mich. P.A. 1970

For corners in
Gogebic
(County)

Located In: Corner Code #
Section 28, 47N 42W G-9-10
T R
T R
T R
T R
S T R
S T R
S T R
S T R

1. Public Land Survey

2. Property Controlling
in Section

3. Miscellaneous
Property in Sec.

4. Lot No. , Recorded Plat
5. Private Claims

Meander corner to sections 27 and 28, T47N, R42W

I, John R. Garske, in a field survey on Sept/Oct, 19 97 do hereby state that under requirements of P.A. 74, Michigan P.A. of 1970, the corner points mentioned in lines 1 and 2 above were in conformance with regulations and rules therefore as required in the current manual of survey instructions of the United States Department of the Interior, Bureau of Land Management or by a decree of a Court of Law and/or that the corner points mentioned in lines 3, 4 and 5 above were in conformance with the rules of the Michigan Board of Land Surveyors or by a Decree of a Court of Law; established, re-established, monumented, recovered, found as expressed below:

NOTE: Not more than 2 corners, all in the same town and range, may be recorded on this certificate.

A. Description of original monument and accessories and/or subsequent restoration:

Original survey by A. Merryweather, D.S. 1851
Cedar 3" corner Tree
Hemlock 10" S20W - 7links

1930 - Corner shown on the Lieberthal Plat by George Koronski as a 1" iron rod incased in concrete.

B. Description of corner evidence found and/or method applied in restoring or reestablishing corner:

I found several corners in the Lieberthal Plat, including a 6" dia. concrete monument at the S.W. corner of the Plat, I calculated the M.C. position from the Plat and found a 6" dia. concrete monument lying down at the top of the bank over looking Lake Gogebic. I monumented the calculated position which falls along a grass line/occupation line.

(Research on file)


PEER GROUP APPROVED
Richard P. Dean 10/8/97
COUNTY REPRESENTATIVE

C. Description of monument for corner and accessories established to perpetuate locating the position of the corner:

I set a 3/4" dia. x 36" long alum. rod with a 3 1/4" dia. alum. cap stamped to identify the corner, from which;		
S.E corner house foundation	N 84°W	44.49 feet
4" sugar	N 87°E	3.48 feet
18" sugar	N 41°W	11.59 feet
2" iron pipe	S 36°W	41.48 feet
6" dia. conc. mon.	S 42°04'27"W	380.27 feet
M.C. to Sections 21 and 28	N 53°-20'00"W	811.39 feet
(MDNR) monument)		811.1 feet(R)

Signed by John R. Garske
Surveyor's Michigan License No. 28410

Date 10/7/97

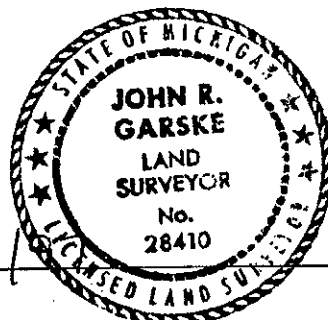

Register's Office } ss.
Gogebic County }

Received for record the
9TH day of OCTOBER
A. D. 19 97 at 11:00 o'clock
A m., and recorded in
Liber 6 of CORNERS
on page 242
Ramona Collins, Deputy
Register of Deeds

Register of Deeds Stamp & File Number

	A	B	C	D	E	F	G	H	I	J	K	L	M
1													
2		6		5		4		3		2		1	
3													
4		7		8		9		10		11		12	
5													
6		18		17		16		15		14		13	
7													
8		19		20		21		22		23		24	
9													
10		30		29		28		27		26		25	
11													
12		31		32		33		34		35		36	
13													

47-42-1 G 9-10

SKETCH
No Scale

