

MAY 16 1987

COMMISSION

LAND CORNER RECORDATION CERTIFICATE  
Filing Requirement of Act 74, Mich. P.A. 1970

Register's Office }  
Gogebic County } ss.

Received for record the  
17<sup>TH</sup> day of OCTOBER  
A. D. 1996 at 9:50 o'clock  
A m., and recorded in  
Liber 6 of CORNERS  
on page 72  
Ramona Collins, Deputy  
Register of Deeds

Register of Deeds Stamp & File Number

For corners in

Gogebic  
(County)

Located In:

Corner Code #

- 1. Public Land Survey T 48N R 44W K-3
- T \_\_\_\_\_ R \_\_\_\_\_
- T \_\_\_\_\_ R \_\_\_\_\_
- T \_\_\_\_\_ R \_\_\_\_\_
- 2. Property Controlling S \_\_\_\_\_ T \_\_\_\_\_ R \_\_\_\_\_
- in Section S \_\_\_\_\_ T \_\_\_\_\_ R \_\_\_\_\_
- 3. Miscellaneous S \_\_\_\_\_ T \_\_\_\_\_ R \_\_\_\_\_
- Property in Sec. S \_\_\_\_\_ T \_\_\_\_\_ R \_\_\_\_\_

- 4. Lot No. \_\_\_\_\_, Recorded Plat \_\_\_\_\_
- 5. Private Claims \_\_\_\_\_

Sec. Cor. 1, 2, 11 & 12; T.48 N., R.44 W.

I, Richard L. Drahn in a field survey on October 1, 1996, 19\_\_\_\_\_, do hereby certify that under requirements of P.A. 74, Michigan P.A. of 1970, the corner points mentioned in lines 1 and 2 above were in conformance with regulations and rules therefore as required in the current manual of survey instructions of the United States Department of the Interior, Bureau of Land Management or by a decree of a Court of Law and/or that the corner points mentioned in lines 3, 4 and 5 above were in conformance with the rules of the Michigan Board of Land Surveyors or by a Decree of a Court of Law; established, re-established, monumented, re-monumented, recovered, found as expressed below:

**NOTE: Not more than 4 corners, all in the same town and range, may be recorded on this certificate.**


A. Description of original monument and accessories and/or subsequent restoration:

Corner established by Austin Burt on 9/4/1848. Original B.T.s --- Lynn 14" S.47½ W. 28 links (18.48') --- Sugar Maple 12" N.20 E. 27 links (17.82')  
Corner restored by Donald D. Lappala, RLS 12585 on 8/8/68 from the remains of the two original B.T.s and from line tree remains north and south. He set a 2" X 5' iron pipe monument with a 3" stamped brass cap and the following new B.T.s: --- 7" (10") Sugar Maple N.38 E. (N.39 E.) 13.8' (13.87') --- 13" Elm (19" dead Elm stub) S.23 W. (S.25 W.) 16.2' (16.18') --- 12" (15") Sugar Maple S.88 W. (N.89 W.) 28.1' (27.70') ---  
Corner recorded in Gogebic County in USFS Liber, Page E-21 on 3/31/69.

B. Description of corner evidence found and/or method applied in restoring or reestablishing corner:

Recovered the monument as described and the bearing trees as noted in parentheses above. No evidence remains of the original Lynn bearing tree. Portions of a badly decayed large Sugar Maple stump remain from the second B.T.

Act 74 research form on file with Gogebic County records.

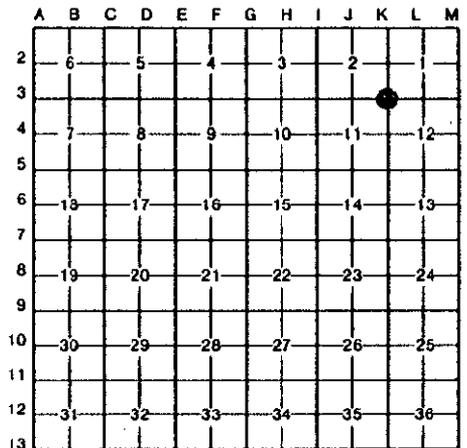

DEER GROUP APPROVED  
Richard L. Drahn 10/16/96  
COUNTY REPRESENTATIVE

C. Description of monument for corner and accessories established to perpetuate locating the position of the corner:

Bearing objects referenced:

- 11" Sugar Maple S.12 W. 18.70'
- 4" X 4" Cedar sign post N.80 W. 0.35'
- 6' Steel sign post N.26 E. 2.76'



Signed by Richard L. Drahn

Date October 2, 1996

Surveyor's Michigan License No. 21564