

MAR 02 2000

SECTION

LAND CORNER RECORDATION CERTIFICATE
Filing Requirement of Act 74, Mich. P.A. 1970

Register's (Office) } ss.
Gogebic County }

For corners in

Gogebic Located In: Corner Code #
(County)

1. Public Land Survey T 48N R 45 W. K-3
T R
T R
T R

2. Property Controlling S T R
in Section S T R

3. Miscellaneous S T R
Property in Sec. S T R

Received for record the
26TH day of AUGUST
A. D. 1999 at 1:40 o'clock
P m., and recorded in
Lib. 7 of CORNERS
on page 234
Ramona Collins, Deputy
Register of Deeds

Register of Deeds Stamp & File Number

4. Lot No. , Recorded Plat
5. Private Claims

Section corner 1, 2, 11 & 12; T.48 N., R.45 W.

I, Richard L. Drahn, in a field survey on July 22, 1999 do hereby state that under requirements of P.A. 74, Michigan P.A. of 1970, the corner points mentioned in lines 1 and 2 above were in conformance with regulations and rules therefore as required in the current manual of survey instructions of the United States Department of the Interior, Bureau of Land Management or by a decree of a Court of Law and /or that the corner points mentioned in lines 3, 4 and 5 above were in conformance with the rules of the Michigan Board of Land Surveyors or by a Decree of a Court of Law; established, re-established, monumented, recovered, found as expressed below:

NOTE: Not more than 2 corners, all in the same town and range, may be recorded on this certificate.

	A	B	C	D	E	F	G	H	I	J	K	L	M
1													
2	6		5		4		3		2		1		
3													
4	7		8		9		10		11		12		
5													
6	18		17		16		15		14		13		
7													
8	19		20		21		22		23		24		
9													
10	30		29		28		27		26		25		
11													
12	31		32		33		34		35		36		
13													

A. Description of original monument and accessories and/or subsequent restoration:

Original corner established by Austin Burt on 9/18/1848. Original bearing trees:

Maple	8"	S.58° W.	35 links	(23.10')
Hemlock	16"	N.74° E.	6 links	(3.96')

Neal Sperhake, RLS 7876, on 11/9/61, restored the corner position from the remains of the original Maple bearing tree. He set a 1" X 36" iron pipe monument with a 4" stamped aluminum cap and the following new bearing trees:

Maple	7"	N.38° E.	21 links	(13.86')
Ash	8"	N.70° W.	44 links	(29.04')
Hemlock	10"	S.24° W.	41 links	(27.06')
Cedar	9"	S.62° E.	30 links	(19.80')

B. Description of corner evidence found and/or method applied in restoring or reestablishing corner:

Recovered Sperhakes corner as described and his bearing trees as follows:

Red Maple	10"	N.36° E.	13.73'	new nail
Black Ash (dead)		N.67° W.		
Hemlock	16"	S.27° W.	27.54'	new nail
Cedar	13"	S.58° E.	19.52'	new nail

The original Maple B.T. is now a large downed and decayed Red Maple. The original Hemlock is now a badly decayed Hemlock stump.

Corner research on file with Gogebic County records.

C. Description of monument for corner and accessories established to perpetuate locating the position of the corner:

New bearing object referenced:


Steel sign rail 6' N.62° W. 2.91'

PEER GROUP APPROVAL

Richard L. Drahn 8/24/99
COUNTY CLERK

Signed by Richard L. Drahn Date August 10, 1999

Surveyor's Michigan License No. 21564

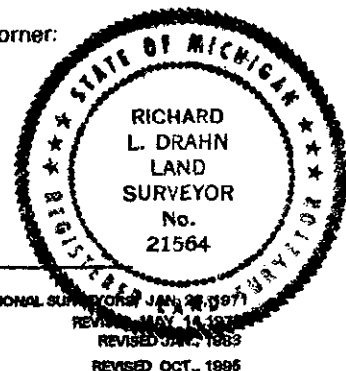

FORM APPROVED BY MICHIGAN STATE BOARD OF PROFESSIONAL SURVEYORS JAN 28, 1997
REVISED MAY 14, 1998
REVISED JAN, 1999
REVISED OCT., 1996