

SURVEY & REMONUMENTATION

SEP 08 1998

LAND CORNER RECORDATION CERTIFICATE Filing Requirement of Act 74, Mich. P.A. 1970

SECTION

For corners in

<u>Gogebic</u> (County)	Located In:	Corner Code #
1. Public Land Survey	Section 29 T48N R 47W	C-11
	T R	
	T R	
	T R	
2. Property Controlling in Section	S T R	
	S T R	
3. Miscellaneous	S T R	
Property in Sec.	S T R	

Register's Office
Gogebic County ss.

Received for record the
14th day of MAY
A. D. 1998 at 3:30 o'clock
P. m., and recorded in
Liber 6 of CORNER
on page 394
Ramona Collins, Dep.
Register of Deeds

Register of Deeds Stamp & File Number

4. Lot No. _____, Recorded Plat _____
5. Private Claims _____

Section Corner, 29, 30, 31, & 32, T48N, R47W

I, John R. Garske, in a field survey on April 6, 1998, do hereby state that under requirements of P.A. 74, Michigan P.A. of 1970, the corner points mentioned in lines 1 and 2 above were in conformance with regulations and rules therefore as required in the current manual of survey instructions of the United States Department of the Interior, Bureau of Land Management or by a decree of a Court of Law and/or that the corner points mentioned in lines 3, 4 and 5 above were in conformance with the rules of the Michigan Board of Land Surveyors or by a Decree of a Court of Law; established, re-established, monumented, recovered, found as expressed below:

NOTE: Not more than 2 corners, all in the same town and range, may be recorded on this certificate.

	A	B	C	D	E	F	G	H	I	J	K	L	M
1													
2	6		5		4		3		2		1		
3													
4	7		8		9		10		11		12		
5													
6	18		17		16		15		14		13		
7													
8	19		20		21		22		23		24		
9													
10	30		29		28		27		26		25		
11													
12	31		32		33		34		35		36		
13													

A. Description of original monument and accessories and/or subsequent restoration:

Original corner set by William Ives, D.S. in 1848.
Original bearing trees: Sugar 12"- S40°W- 29 links
hemlock 14"- N53E- 13 links

B. Description of corner evidence found and/or method applied in restoring or reestablishing corner:


I could find nothing at the corner location, so I established the corner position at the intersection of Norland and Airport Rds. This location fits well with fence lines down Airport Road and generally fits with fence line/ R/W splits down Norland and Airport Roads.

(Research on file)

PEER GROUP APPROVED
Richard P. Diden 5/13/98
COUNTY REGISTER

C. Description of monument for corner and accessories established to perpetuate locating the position of the corner:

I set a 3 1/4" Brass cap on a 5/8" diam. x 10" long iron rod from which I established:
22" Twin Sugar Maple S42°W 52.55 feet
10" Sugar Maple N42°W 47.30 feet
Power Pole N47°W 47.80 feet
Reference Monument N38°W 47.10 feet
Steel sign rail S38°E 1.50 feet from R. M.
(R.M. is a 3 1/4" diam. aluminum cap on a 2 1/2" x 30" diam aluminum rod)

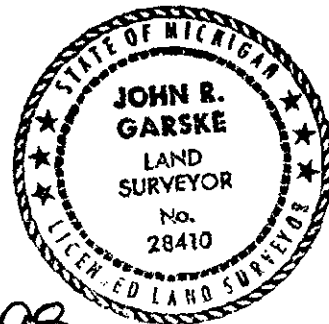

Signed by John R. Garske
Surveyor's Michigan License No. 28410

Date 5/12/98