

LAND CORNER RECORDATION CERTIFICATE
Filing Requirement of Act 74, Mich. P.A. 1970

Register's Office }
Gogebic County } ss.

For corners in
Gogebic
(County)

Located In: Corner Code ##

Received for record the
30th day of DECEMBER
A. D. 1993 at 12:25 o'clock
P m., and recorded in
Liber 4 of CORNERS
on page 329
Betty Laine Deputy
Register of Deeds

Register of Deeds Stamp & File Number

1. Public Land Survey	T <u>47N</u> R <u>47W</u>	<u>G-1</u>
	T _____ R _____	
	T _____ R _____	
	<u>T 48N</u> R <u>47W</u>	<u>G-13</u>
2. Property Controlling in Section	S _____ T _____ R _____	<u>G-13</u>
	S _____ T _____ R _____	
3. Miscellaneous	S _____ T _____ R _____	
Property in Sec.	S _____ T _____ R _____	

4. Lot No. _____, Recorded Plat _____
5. Private Claims _____

Section corner 3 & 4, T47N, R47W, S-33 & S-34, T48N, R47W.

I, John R. Garske, in a field survey on December 15, 1993, do hereby certify that under requirements of P.A. 74, Michigan P.A. of 1970, the corner points mentioned in lines 1 and 2 above were in conformance with regulations and rules therefore as required in the current manual of survey instructions of the United States Department of the Interior, Bureau of Land Management or by a decree of a Court of Law and/or that the corner points mentioned in lines 3, 4 and 5 above were in conformance with the rules of the Michigan Board of Land Surveyors or by a Decree of a Court of Law; established, re-established, monumented, re-monumented, recovered, found as expressed below:

NOTE: Not more than 4 corners, all in the same town and range, may be recorded on this certificate.

A. Description of original monument and accessories and/or subsequent restoration:

Sugar post set by William Austin Burt, August 1848.

Elm 14" - N70°E - 25 links
Elm 12" - N7°W - 11 links

B. Description of corner evidence found and/or method applied in restoring or reestablishing corner:

No original evidence found. Found a P.K. nail at the corner location at the center line intersection of Vanderhagen and North Star Roads. This corner position has been used and accepted as the section corner in several surveys of record, by area residents and the County Road Commission.

C. Description of monument for corner and accessories established to perpetuate locating the position of the corner:

Replaced nail with an 8" cotton gin spike and established the following bearing trees and/or reference objects:

Light pole - N21°E - 84.24 feet
Telephone pole - S50°E - 47.88 feet
Power pole - S34°W - 62.30 feet
Power pole - N43°W - 49.94 feet

Set two reference monuments being 2 1/2 x 30" aluminum Bernsten monuments with 3 1/2" caps stamped: County Remonumentation, 1993, S-3, S-4, T47N, R47W, S-33, S-34, T48N, R47W RLS 28410. - N45°E - 60.00 feet and steel rail 2.00 feet and a reference monument - Set at S57°W - 61.00 feet and steel rail 1.99 feet.


Signed by John R Garske Date 12/21/93

Surveyor's Michigan License No. 28410

FORM APPROVED BY MICHIGAN STATE BOARD OF LAND SURVEYORS, JAN. 28, 1971
REVISED MAY 14, 1975
REVISED JAN., 1983

FED: A-13

	A	B	C	D	E	F	G	H	I	J	K	L	M
2	6	5	4	3	2	1							
3													
4	7	8	9	10	11	12							
5													
6	18	17	16	15	14	13							
7													
8	19	20	21	22	23	24							
9													
10	30	29	28	27	26	25							
11													
12	31	32	33	34	35	36							
13													

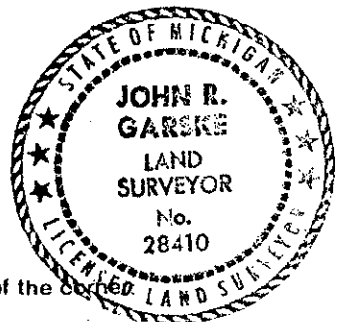

PEER GROUP APPROVED
Richard E. Albrecht 3/1/95
COUNTY REPRESENTATIVE