

LAND CORNER RECORDATION CERTIFICATE
Filing Requirement of Act 74, Mich. P.A. 1970

Register's Office }
Gogebic County } ss.

For corners in

Gogebic

(County)

Located In:

Corner Code ##

1. Public Land Survey Section 11 T 48N R 49W
T R
T R
T R
2. Property Controlling S T R
in Section S T R
3. Miscellaneous S T R
Property in Sec. S T R

J-K-3

002

Received for record the
30th day of DECEMBER
A. D. 1993 at 12:30 o'clock
P. M., and recorded in
Liber 4 of CORNERS
on page 338

Betty Soars, Deputy
Register of Deeds

Register of Deeds Stamp & File Number

4. Lot No. , Recorded Plat

5. Private Claims

Meander corner Section 2 & 11.

I, John R. Garske, in a field survey on December 1, 1993, do hereby certify that under requirements of P.A. 74, Michigan P.A. of 1970, the corner points mentioned in lines 1 and 2 above were in conformance with regulations and rules therefore as required in the current manual of survey instructions of the United States Department of the Interior, Bureau of Land Management or by a decree of a Court of Law and/or that the corner points mentioned in lines 3, 4 and 5 above were in conformance with the rules of the Michigan Board of Land Surveyors or by a Decree of a Court of Law; established, re-established, monumented, re-monumented, recovered, found as expressed below:

NOTE: Not more than 4 corners, all in the same town and range, may be recorded on this certificate.

A. Description of original monument and accessories and/or subsequent restoration:

Original survey by William Ives, Deputy Surveyor, on August 11, 1848. Set meander post.
Bearing trees:

12" hemlock - N86°E - 22 links
14" hemlock - S42°E - 42 links

No original evidence found.

B. Description of corner evidence found and/or method applied in restoring or reestablishing corner:

Established the meander corner at the top of the bank overlooking Lake Superior on a line parallel with the south line of Section 1, running from the monumented section corner of Sections 1, 2, 11 and 12. No original or subsequent evidence of this corner could be found.

The corner was reestablished in this manner after we had tied in to several corners in the area and comparing bearings to each line. This line matches occupation lines used by area residents for many years.


PEER GROUP APPROVED

Richard L. Ozalim 4/7/94
COUNTY REPRESENTATIVE

C. Description of monument for corner and accessories established to perpetuate locating the position of the corner:

Set standard Bernsten 2 1/2" aluminum pipe with 3 1/2" aluminum cap stamped: County Remonumentation; T48N, R49W; M.C.; S-2; S-11; 1993; RLS 28410. Established the following bearing trees and reference objects:

3" white birch - N48°E - 7.32 feet
10" red pine - S88°E - 12.93 feet
10" red pine - S19°E - 9.43 feet
Steel sign post - N48°W - 0.55 feet

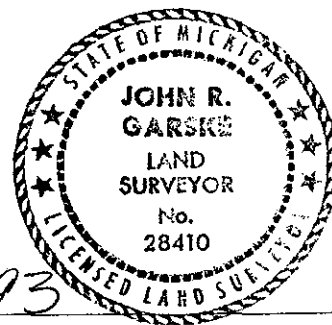

Signed by John R. Garske
Surveyor's Michigan License No. 28410

Date 12/20/93