

MICHIGAN
DEPARTMENT OF CONSERVATION
FORESTRY DIVISION

LAND CORNER RECORD

T. 25 N.R. 9 W


GRAND TRAVERSE COUNTY

DESCRIPTION OF CORNER M. C. common to sections 13 & 14, on N side of Helen Is. in Fife Lake

CORNER MONUMENT Fd. old rusty 1 1/2" pipe at edge of water

DATE MONUMENT PLACED AND WITNESSED 3/29/69

WITNESSES TO CORNER..... Set 5" square top Cedar Guard Post

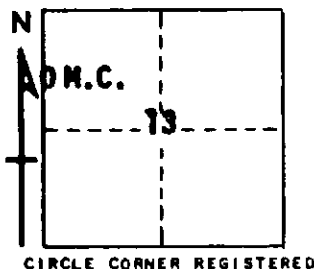

7" R. Pine S 54 E 78.1'

8" Cedar S 55 W 19.1'

AND

DESCRIPTION IN DETAIL AS TO HOW CORNER WAS LOCATED AND IDENTIFIED OR RESTORED.

This corner was recovered during retracement survey in this area. The corner fits witness and data by D. E. Teed, U.S. Deputy Surveyor, dated May 5, 1903.

For additional info see PLAT OF SURVEY.

SURVEYOR'S SEAL

SIGNED

Carl J. Boer
REGISTERED LAND SURVEYOR 12028

DATE

5/29/69