

LAND CORNER RECORDATION CERTIFICATE
FILING REQUIREMENT OF ACT 74, MICH. P.A. 1970

FOR CORNERS OF--:	LOCATED IN--:	CORNER CODE NUMBER
1. PUBLIC LAND SURVEY _____	T. <u>25</u> ^{N.} _○ R. <u>11</u> ^{W.} _○	F-9; F-10
2. PROPERTY CONTROLLING IN SECTION <u>28</u>	T. <u>25</u> ^{N.} _○ R. <u>11</u> ^{W.} _○	5; 16
3. MISCELLANEOUS PROPERTY IN SECTION _____	T. _____ ^{N.} _○ R. _____ ^{E.} _○	
4. LOT NO. _____, RECORDED PLAT _____		
5. PRIVATE CLAIMS _____		

REGISTER OF DEEDS STAMP AND
FILING NUMBER

I, Carl F. Roser do hereby certify that under requirements of P.A. 74, Michigan P.A. of 1970, the corner points mentioned in lines 1 and 2 above (identified with circles on index code diagram—over) were, in a field survey on March 26, 19 74, established, re-established, monumented, re-monumented, recovered or restored as expressed below and in conformance with regulations and rules therefore as required in the current manual of survey instructions of the United States Department of the Interior, Bureau of Land Management or by a decree of a court of law. Furthermore, that the corner points mentioned in lines 3, 4 and 5 above were, in a field survey on _____ 19____, found, recovered, restored, established or re-established as expressed below and in conformance with the rules of the Michigan State Board of Registration for Land Surveyors or, by a Decree of a Court of law:

(continued)

C. A-Description of original monument and accessories and/or subsequent restoration

16

Set 1"x36" pipe & cedar post w/loc. tag	
24" Twin Maple	N67°W 23.1
14" Maple	N84°E 32.9
10" Maple	S51°E 32.4
E-W fence remains	Due N 10'
E-W fence remains	Due S 12'
E-W random	Due S 17'

B. Description of corner evidence found and/or method applied in restoring or re-establishing corner:

- F-9 Found Wilcox & Erickson iron which was set on basis of old E.P. Waterman survey.
- F-10 Restored center of section in road intersection, in line with fence remains west and split of road ROW fences to E-N-S. Fits record of old center of section, Liber II, page 210, Nov. 1899. Fits computed intersection of $\frac{1}{4}$ lines within 4' for position.
- 5 Established corner per standard B.L.M. instructions.
- 16 Established corner per standard B.L.M. instructions.

C. Description of monument for corner and accessories established to perpetuate locating the position of the corner:

F-9	F-10	5
Found iron, added DNR mon. & cedar post	Set 1"x36" pipe, buried in dirt rd. intersection N-S-E	Set 1"x36" pipe, buried in N-S road
10" Hemlock S86°W 42.97	P. Pole S71°E 104.99	14" W. Pine S56°E 45.3
6" Maple N39°W 30.98	6" R. Pine S62°W 86.81	12" W. Pine N34°E 72.5
5" Maple N19°E 67.97	5" J. Pine S85°W 60.02	6" Maple S38°W 73.0
	Set cedar post w/loc. tag	Set cedar post w/loc. tag
	Due W 33	Due W 33

SIGNED BY Carl F. Roser

DATE 7-3-74

SURVEYOR'S MICHIGAN REGISTRATION NO. 12028

FOR STATE AND UNITED STATES AGENCIES:

SIGNED BY _____


CHIEF OF SURVEY PARTY

DATE _____

APPROVED AND SIGNED BY _____

MICHIGAN REGISTERED LAND SURVEYOR

DATE _____

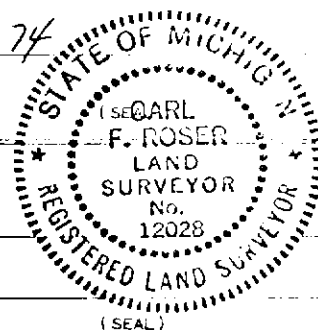

SURVEYOR'S MICHIGAN REGISTRATION NO. _____

MAYFIELD Twp.
GRAND TRAVERSE COUNTY