

MAY 07 1997

COMMISSION

LAND CORNER RECORDATION CERTIFICATE  
Filling Requirement of Act 74, Mich. P.A. 1970

For corners in

Grand Traverse

(County)

Located In:

Corner Code #

1. Public Land Survey

T 25 N R 12 W F-09

G.T. County Code 96-20

I, Corey J. Hughes, in a field survey performed in October, 1996, do hereby certify that under requirements of P.A. 74, Michigan P.A. of 1970, the corner point mentioned in lines 1 and 2 above was in conformance with regulations and rules therefore as required in the current manual of survey instructions of the United States Department of the Interior, Bureau of Land Management or by a decree of a Court of Law and /or that the corner points mentioned in lines

3, 4 and 5 above were in conformance with the rules of the Michigan Board of Land Surveyors or by a Decree of a Court of Law; established, re-established, monumented, re-monumented, recovered, found as expressed below:

A. Description of original monument and accessories and/or subsequent restoration:

GLO 1838 Burt

Set post

Beech 6 S67W 21lks

Beech 12 N30E 18lks

C.P. Tuller 1891

Found marked stone set by Slawson

Sugar 5 S48°40'E 37 3/4'

Sugar 8 N31°40'E 26 1/4'

	A	B	C	D	E	F	G	H	I	J	K	L	M
2	6	5	4	3	2	1							
3													
4	7	8	9	10	11	12							
5													
6	16	17	18	19	20	21	22	23	24				
7													
8	19	20	21	22	23	24							
9													
10	30	29	28	27	26	25							
11													
12	31	32	33	34	35	36							

UNANIMOUSLY ACCEPTED BY THE  
GRAND TRAVERSE COUNTY PEER  
REVIEW GROUP AS THE OFFICIAL  
CORNER UNDER MICHIGAN PUBLIC  
ACT 345 OF 1990 AT A MEETING  
HELD ON 10-8-96

ROBERT F. MITCHELL, P.S., Chairman

B. Description of corner evidence found and/or method applied in restoring or reestablishing corner:

Found T Iron 2.7' long over large flat stone in old road bed.

C. Description of monument for corner and accessories established to perpetuate locating the position of the corner:


Replaced existing evidence with re-mon monument in CL of gravel road.

Nail in 28" Maple S47°E 85.45'

Nail in 5" Maple S02°E 41.95'

PK in PP N80°E 143.51'

PK in PP N69°W 130.60'

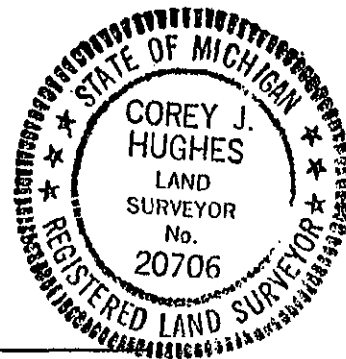

Corner approved by the Grand Traverse County Peer Review Group on October 8, 1996

Signed by

Corey J. Hughes

Corey J. Hughes

Michigan P.S. license No. 20706

Date

12.23.96