

MAY 07 1997

COMMISSION

LAND CORNER RECORDATION CERTIFICATE
Filing Requirement of Act 74, Mich. P.A. 1970

For corners in

Grand Traverse

(County)

Located In: Corner Code

1. Public Land Survey

T 25 N R 12 W G-11

G.T. County Code 96-24

I, Corey J. Hughes, in a field survey performed in October, 1996, do hereby certify that under requirements of P.A. 74, Michigan P.A. of 1970, the corner point mentioned in lines 1 and 2 above was in conformance with regulations and rules therefore as required in the current manual of survey instructions of the United States Department of the Interior, Bureau of Land Management or by a decree of a Court of Law and /or that the corner points mentioned in lines

3, 4 and 5 above were in conformance with the rules of the Michigan Board of Land Surveyors or by a Decree of a Court of Law; established, re-established, monumented, re-monumented, recovered, found as expressed below:

A. Description of original monument and accessories and/or subsequent restoration:

GLO - 1838 - Burt

set post

Sugar 24 N80E 20lks

Beech 12 S19½W 33lks

E.P. Waterman 1907

Stone and Iron

No witnesses

Allyn 1900

no corner desc.

Church steeple N51½E 67½'

Sugar 12' N63W 55'

John Nelson 1978

Found ¼ Iron rod in monument box

Fd nail in SE side power pole Az 35° 71.60'

SW corner of church addition Az 52° 58.40'

Fd nail in NE side of 24" Maple Az 131° 62.23'

Fd nail in SW side 30" Maple Az 300° 55.40'

| | A | B | C | D | E | F | G | H | I | J | K | L | M |
|----|----|---|----|---|----|---|----|---|----|---|----|---|---|
| 2 | 6 | | 5 | | 4 | | 3 | | 2 | | 1 | | |
| 3 | | | | | | | | | | | | | |
| 4 | 7 | | 8 | | 9 | | 10 | | 11 | | 12 | | |
| 5 | | | | | | | | | | | | | |
| 6 | 13 | | 14 | | 15 | | 16 | | 17 | | 18 | | |
| 7 | | | | | | | | | | | | | |
| 8 | 19 | | 20 | | 21 | | 22 | | 23 | | 24 | | |
| 9 | | | | | | | | | | | | | |
| 10 | 25 | | 26 | | 27 | | 28 | | 29 | | 30 | | |
| 11 | | | | | | | | | | | | | |
| 12 | 31 | | 32 | | 33 | | 34 | | 35 | | 36 | | |
| 13 | | | | | | | | | | | | | |

UNANIMOUSLY ACCEPTED BY THE
GRAND TRAVERSE COUNTY PEER
REVIEW GROUP AS THE OFFICIAL
CORNER UNDER MICHIGAN PUBLIC
ACT 345 OF 1990 AT A MEETING
HELD ON 10-22-96

Robert F. Mitchell
ROBERT F. MITCHELL, P.S., CHAIRMAN

B. Description of corner evidence found and/or method applied in restoring or reestablishing corner:

Found monument box containing 3/4"x1.45'rod over 2.5' cast iron machine part over large stone.

C. Description of monument for corner and accessories established to perpetuate locating the position of the corner:


Set County remon monument and pavement box on existing evidence.

SW corner church N56°E 58.46'

PK nail in wood post S50°W 61.44'

Nail in 28' Maple N57°W 55.30'

Nail in 22" Maple S47°E 62.06'

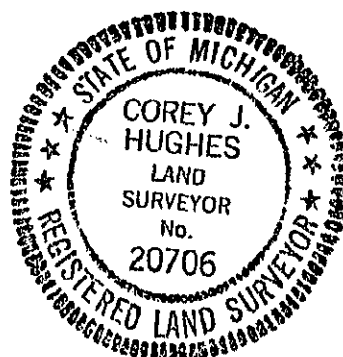

Corner approved by the Grand Traverse County Peer Review Group on October 22, 1996

Signed by *Corey J. Hughes*
Corey J. Hughes

Date 12-23-96

Michigan P.S. license No. 20706