

LAND CORNER RECORDATION CERTIFICATE

FILING REQUIREMENT OF ACT 74, MICH. P.A.1970

FOR CORNERS OF--	LOCATED IN--	CORNER CODE NUMBER
1. PUBLIC LAND SURVEY.....	T. 25 N. R. 12 W.	E-7; E-9
2. PROPERTY CONTROLLING IN SECTION.....	N. S. R. W.	
3. MISCELLANEOUS PROPERTY IN SECTION.....	N. S. R. W.	
4. LOT NO., RECORDED PLAT.....		
5. PRIVATE CLAIMS.....		

REGISTER OF DEEDS STAMP AND FILING NUMBER

I, Carl F. Roser, do hereby certify that under requirements of P.A. 74, Michigan P.A. of 1970, the corner points mentioned in lines 1 and 2 above were, in a field survey on December 4, 1978, established, re-established, monumented, re-monumented, recovered or restored as expressed below and in conformance with regulations and rules therefore as required in the current manual of survey instructions of the United States Department of the Interior, Bureau of Land Management or by a decree of a court of law. Furthermore, that the corner points mentioned in lines 3, 4 and 5 above were, in a field survey on 19, found, recovered, restored, established or re-established as expressed below and in conformance with the rules of the Michigan State Board of Registration for Land Surveyors or, by a Decree of a Court of law:

A. Description of original monument and accessories and/or subsequent restoration:

B. Description of corner evidence found and/or method applied in restoring or re-establishing corner:

E-7 Fd. Dept. mon. as set in 1966 from USBT stump to be in error (set from wrong pine stump). Removed Dept. mon. and reset at position of fd. 1" pipe by C.P. Tuller in 1906 from "fd. old post & two govt. stumps". We fd. Tuller's 1" pipe to fit 14" USBT w. pine stump (showing partial lower face), N04°E 14.5' and Tuller's 28" w. pine stump, N80°W 5 ft. We also fd. USBT pine stump remains (definite) S17°W 8 ft. Dept. mon. in error (removed) would bear N26°28'W 9.9'. Tuller's notes are in L-2, p. 338, of old Co. Sur. Rec. at Reg. of Deeds office.

E-9 Fd. 3/4" pipe buried & surrounded by rocks as recovered & accepted in previous dept. survey of 1966. Corner falls in approx. intersection of roads N, S & E & 15'± S of trail road to W.
C. Description of monument for corner and accessories established to perpetuate locating the position of the corner:

E-7			E-9		
Reset Dept. Mon. at position of fd. 1" pipe & set cedar post.			Fd. 3/4" pipe 10" deep, in gravel road inter., w/3/8" rerod inside, 2"± below road.		
*12" R. Oak	N12°E	18.32	14" Elm Stp.	N38°E	54.31
*10" R. Oak	N23°E	16.31	21" Maple	N35°W	91.95
4" Maple	N81°E	7.7	27" Twn. Maple	N70°W	108.12
5" Maple	N16°W	16.4	Set ced. post w/loc. tag		
E-W Rand. Trav.	Due N	8.5		N45°W	47'±
Ctr. E-W Trl. Rd. North		500'±			

*remarked dept. wit.

SIGNED BY Carl F. Roser 4-8-80 DATE

SURVEYOR'S MICHIGAN REGISTRATION NO. 12028


FOR STATE AND UNITED STATES AGENCIES:

SIGNED BY _____ DATE _____

CHIEF OF SURVEY PARTY

APPROVED AND SIGNED BY _____ DATE _____

MICHIGAN REGISTERED LAND SURVEYOR

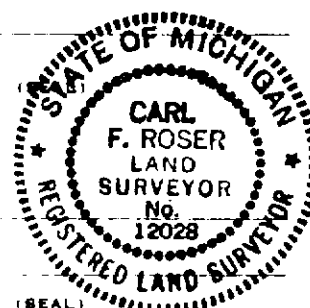

SURVEYOR'S MICHIGAN REGISTRATION NO. _____

GRAND TRAVERSE COUNTY
GRANT TOWNSHIP