

MICHIGAN
DEPARTMENT OF CONSERVATION
FORESTRY DIVISION

LAND CORNER RECORD

T. 26 N.R. 9 W


GRAND TRAVERSE COUNTY

DESCRIPTION OF CORNER 1/4 Corner common to Sections 7 & 8

CORNER MONUMENT Set Std. Dept. Mon. & Cedar Guard Post

DATE MONUMENT PLACED AND WITNESSED December 1968

WITNESSES TO CORNER.....

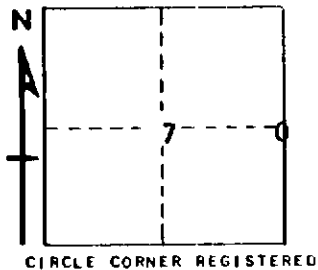

8" Oak	N 70 W	4.5'
8" Oak	N 35 W	23.0'
AND	7" Oak	S 65 E
		33.0'

DESCRIPTION IN DETAIL AS TO HOW CORNER WAS LOCATED AND IDENTIFIED OR RESTORED.

This corner was set by single proportion between Section corners to N & S.

SURVEYOR'S SEAL

SIGNED

Carl F. Rosen

REGISTERED LAND SURVEYOR

#12028

DATE

1/17/69