

MICHIGAN  
DEPARTMENT OF CONSERVATION  
FORESTRY DIVISION

# LAND CORNER RECORD

T. 26 N.R. 9 & 10 W


GRAND TRAVERSE COUNTY

DESCRIPTION OF CORNER Sec. corner common to sections 18-19-13-24

CORNER MONUMENT Set Std. Dept. Mon. and Cedar Guard Post

DATE MONUMENT PLACED AND WITNESSED December 1968

WITNESSES TO CORNER.....

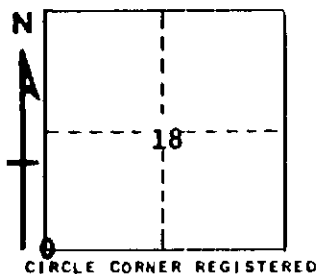

12" Oak	N 60 E	23.3'
14" Oak	S 50 E	48.0'
AND		
12" Oak	S 50 W	61.6'

DESCRIPTION IN DETAIL AS TO HOW CORNER WAS LOCATED AND IDENTIFIED OR RESTORED.

This corner was found as a Schaaf monument (1½" pipe on conc.) in the approximate center of E-W dirt road. Replaced Schaaf monument with Std. Dept. Monument. Schaaf notes show he had an original corner here in 1933. Random to North is 5.0' E. of corner.

SURVEYOR'S SEAL

SIGNED Paul J. Roeder DATE 1/8/69  
REGISTERED LAND SURVEYOR #12028