


LAND CORNER RECORDATION CERTIFICATE
Filing Requirement of Act 74, Mich. PA 1970

For Corners In: Grand Traverse (County) Located In Corner Code #
1. Public Land Survey T 26N R 10W F1
T 27N R 10W F13
2. Property Controlling in Section S T R
S T R
3. Miscellaneous Property in Section S T R
S T R
4. Lot No: Recorded Plat:
5. Private Claims:

I, Craig W. McVean, in a field survey on November 6, 2001 do hereby state that under requirements of PA 74, Michigan PA of 1970, the corner points mentioned in lines 1 and 2 above were in conformance with regulations and rules therefore as required in the current manual of survey instructions of the United States Department of the Interior, Bureau of Land Management or by a decree of a Court of Law and/or that the corner points mentioned in lines 3, 4 and 5 above were in conformance with the rules of the Michigan Board of Land Surveyors or by a Decree of a Court of Law; established, re-established, monumented, recovered, found as expressed below:
NOTE: Not more than 2 corners, all in the same town and range, may be recorded on this certificate.

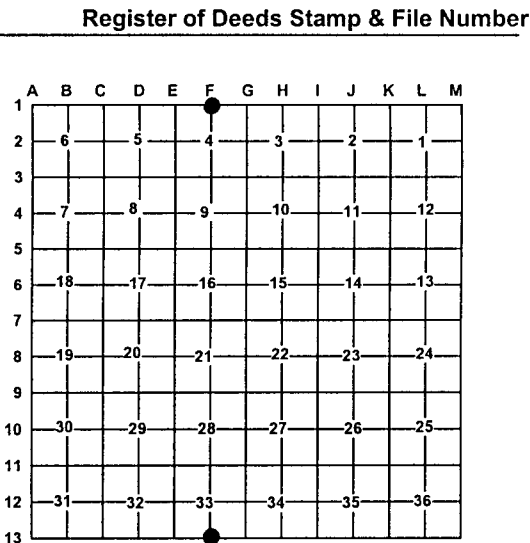

A. Description of original monument and accessories and/or subsequent restoration:
F1&F13 - GLO - Set 1/4 post - Alvin Burt - 1839
Beech 10" N70°E 6 L.
Hemlock 14" N19°W 43 L.
- CSR - L. 11, P. 93 & 94 - S.C. Hodgman - 1883 - Sec. 33 - Began at SW SC East 39.80 Ch. Fd. 1/4 post from witness alive & stp. of the other. Set new cedar post.
- CSR - L. 10, P. 49 - E.P. Waterman - 1918 - Re-establish 1/4 post by using Hodgman's figure E of #58 & corrected random on to the M. PO. Pine stp. on E. side of Chandler Lake - Stake, iron & mound of earth.
- Consumer's Power Co. - Drawing "S-F 16878" - 1968 - 1/2" iron found
Group 6" Maples N16°E 27.20'; Tw. 8" Oak N79°E 62.71'; 8" Elm N65°W 47.33'
- "Chandler Lake Estates" - L. 10 of plats, P. 90-92 - 1972 - W.R. Donnan - Placed Conc. Mon.
-LCRC - L. 2, P. 78 - G.F. DeLaMater - 1974 - Monument Fd.; N30°W 13.94' 8" W. Pine; N80°E 62.60' 10" Tw. Oak, N10°E 27.04' - 12" Maple

B. Description of corner evidence found and/or method applies in restoring or re-establishing corner:
F1 & F13 - Standard 1/4 Cor. common to Sec. 4, T26N, R10W & Sec. 33, T27N, R10W - Fd. 4" Dia. Conc. Mon. w/ 1/2" iron rod per plat & LCRC. Distance to West fits Hodgman & Watermans distance closely to apparent E1-E13. Conc. Mon. accepted as the best available evidence of the position of the original corner.

C. Description of monument for corner and accessories established to perpetuate locating the position of the corner:
F1 & F13 - 4" Conc. Mon. w/ 1/2" iron rod.
N88°W 30.80' (30.60'-P) to Fd. leaning conc. plat mon.
N24°W 13.9' to centerline 20" W. Pine (GFD)
N36°E 23.48' to SW Cor. wood siding of HSE
S30°E 43.61' to NE Cor. woodsiding on Blk. Fndt.
N78°E 62.5' to reaction in S side Tw. 16" R. Oak (CPC, GFD)



Signed by: [Signature] Date: 2/12/2002
Surveyor's Michigan License No.: 39088