


LAND CORNER RECORDATION CERTIFICATE
Filing Requirement of Act 74, Mich. PA 1970

For Corners In: Grand Traverse (County) Located In Corner Code #
1. Public Land Survey T 26N R 10W F2
2. Property Controlling in Section S T R
3. Miscellaneous Property in Section S T R
4. Lot No: Recorded Plat:
5. Private Claims:

I, Craig W. McVean, in a field survey on November 7, 2001 do hereby state that under requirements of PA 74, Michigan PA of 1970, the corner points mentioned in lines 1 and 2 above were in conformance with regulations and rules therefore as required in the current manual of survey instructions of the United States Department of the Interior, Bureau of Land Management or by a decree of a Court of Law and/or that the corner points mentioned in lines 3, 4 and 5 above were in conformance with the rules of the Michigan Board of Land Surveyors or by a Decree of a Court of Law; established, re-established, monumented, recovered, found as expressed below:
NOTE: Not more than 2 corners, all in the same town and range, may be recorded on this certificate.

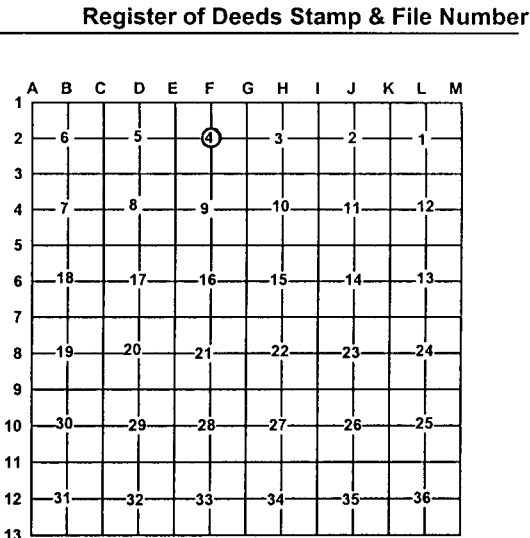

A. Description of original monument and accessories and/or subsequent restoration:
F2 - CSR. - L.6, P. 284-285; L. 7, P. 11, 27-29 - C.O. Carver-
1920's - Set stake. Stake is 6' W & 2.1'N from an iron pipe set by unknown person.
- GTC Rd. Comm. - Fd. bolt - N20°W Tree 69.99'; N31°E Tree 54.70'
- "Kenona Woods" - L. 13 of Plats, P. 74 - L.J. Czubak - 1978 Fd. 5/8" iron bar
- Rec. Survey - L. 7, P. 735 - 1993; L. 7, P. 778 - 1994; L. 7, P. 962 - 1995

B. Description of corner evidence found and/or method applies in restoring or re-establishing corner:
F2 - C ¼, Sec. 4 - T26N, R10W - Fd. ½" CIR #25875 & 21568 on N. edge of Bit. Rd. in agreement w/ Plat & Record Surveys. J.A. Gavin per his Rec. Surveys L. 7, P. 735 & 962 indicates he reset center post based on plat at position previously established at intersection of ¼ lines per Gourdie - Fraser & Assoc. Survey #70309. Centerline of E-W Bit. Rd. is 8.5' S. ½" CIR fits calculated intersection of ¼ lines closely. ½" CIR accepted as the best available evidence of the position of the corner.

C. Description of monument for corner and accessories established to perpetuate locating the position of the corner:
F2 - Replaced ½" x 18" long rebar w/ cap #25875-21568 with 2" Alum. Cap on 5/8" x 34" Rebar in Mon. Box.
North 33.20 (33'-P) to N. Leaning Conc. plat Mon.
South 38.03' (38.04'-R) to Fd. ½" CIR #25875-21568
S58°E 75.03' to set N & T in PP
N23°W 117.75' to SE Cor. Blk Fdtn. of HSE.



Signed by: [Signature] Date: 2/12/2002
Surveyor's Michigan License No.: 39088