


LAND CORNER RECORDATION CERTIFICATE
Filing Requirement of Act 74, Mich. PA 1970

For Corners In: Grand Traverse (County) Located In Corner Code #
1. Public Land Survey T 26N R 10W G2
2. Property Controlling in Section S T R
3. Miscellaneous Property in Section S T R
4. Lot No: Recorded Plat:
5. Private Claims:

I, Craig W. McVean, in a field survey on November 7, 2001 do hereby state that under requirements of PA 74, Michigan PA of 1970, the corner points mentioned in lines 1 and 2 above were in conformance with regulations and rules therefore as required in the current manual of survey instructions of the United States Department of the Interior, Bureau of Land Management or by a decree of a Court of Law and/or that the corner points mentioned in lines 3, 4 and 5 above were in conformance with the rules of the Michigan Board of Land Surveyors or by a Decree of a Court of Law; established, re-established, monumented, recovered, found as expressed below:
NOTE: Not more than 2 corners, all in the same town and range, may be recorded on this certificate.

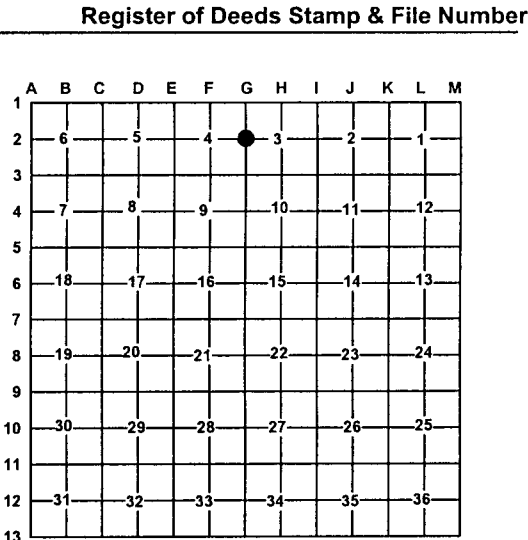

A. Description of original monument and accessories and/or subsequent restoration:
G2 - GLO - Set 1/4 post - L.S. Scranton - 1852
W. Oak 14" N78°W 40 L.
W. Oak 8" N35°E 16 L.
- CSR - L. 6, P. 284-285 & L. 7, P. 11, 27-29 - C.O. Carver - 1920's - Notes indicate a stake was set.
- G.A. Shadko - 1942 - DNR Sur. of PAS #28-3 & 28-4 Sec. 3 - Fd. 1" pipe by Co. Surveyor.
- "Timber Hill" L. 13 of plats, P. 59 - R.A. Rademaker - 1978.
- Rec. Sur. - L. 7, P. 722 - G.D. Stowe - 1993 Conc. Mon. Fd.; Tri Oak 24" N45°E 47.38' Oak 10" S80°W 30.17'; PP - South 81.45'
- Rec. Sur. - L. 8, P. 227 - J.A. Gavin - 1996 Fd. Conc. Mon.; 12" Oak N48°E 47.36'; 14" W. Pine N43°W 24.83'; 10" Oak S82°W 30.06'; 14" W. Pine S36°W 33.33'; 8" Oak 531°E 40.05'
B. Description of corner evidence found and/or method applies in restoring or re-establishing corner:
G2 - 1/4 Cor. common to Sec. 3 & 4 - Fd. broken 4" conc. mon. w/ bent 1/2" iron rod. - Straighten iron rod - per Rec. Surveys. Fits Shadko position for corner. Conc. Mon. accepted as the best evidence of the position of the original corner.

C. Description of monument for corner and accessories established to perpetuate locating the position of the corner:
G2 - 4" Round Broken Conc. Mon. w/ 1/2" iron rod.
Set Blue Carsonite Post w/ loc. tag 1' SW
N48°E 47.55' to set N & T in NE side 14" R. Oak (GDS, JAG)
N43°W 24.91' to set N & T in SW side 19" W. Pine (JAG)
S33°E 40.02' to set N & T in NE side 12" R. Oak (JAG)
S82°W 30.14' to Fd. nail in NW side 12" W. Oak (JAG)
S30°W 33.25' to set N & T in SE side 17" W. Pine (JAG)
S1°W 81.40' to Fd. nail in E side PP (GDS)



Signed by: [Signature] Date: 2/12/2002
Surveyor's Michigan License No.: 39088