

# SURVEY & REMONUMENTATION

APR 07 1998

LIBER 003 PAGE 780

## SECTION

### LAND CORNER RECORDATION CERTIFICATE Filing Requirement of Act 74, Mich. P.A. 1970

For corners in

<u>Grand Traverse</u>	Located In:	Corner Code #
(County)		
1. Public Land Survey	T26N R11W	I-1
	T R	
	T R	
	T R	
2. Property Controlling in Section	S T R	
	S T R	
3. Miscellaneous	S T R	
Property in Sec.	S T R	

STATE OF MICHIGAN  
GRAND TRAVERSE COUNTY  
RECORDED  
**COPY**  
31 DEC 97 12:54 P.M.  
KARON ANDERSON  
REGISTER OF DEEDS

Register of Deeds Stamp & File Number

4. Lot No. \_\_\_\_\_, Recorded Plat \_\_\_\_\_  
5. Private Claims \_\_\_\_\_

I, Garth Stowe, in a field survey on October, 19 97 do hereby state that under requirements of P.A. 74, Michigan P.A. of 1970, the corner points mentioned in lines 1 and 2 above were in conformance with regulations and rules therefore as required in the current manual of survey instructions of the United States Department of the Interior, Bureau of Land Management or by a decree of a Court of Law and /or that the corner points mentioned in lines 3, 4 and 5 above were in conformance with the rules of the Michigan Board of Land Surveyors or by a Decree of a Court of Law; established, re-established, monumented, recovered, found as expressed below:

NOTE: Not more than 2 corners, all in the same town and range, may be recorded on this certificate.

	A	B	C	D	E	F	G	H	I	J	K	L	M
1													
2		6		5		4		3		2		1	
3													
4		7		8		9		10		11		12	
5													
6		18		17		16		15		14		13	
7													
8		19		20		21		22		23		24	
9													
10		30		29		28		27		26		25	
11													
12		31		32		33		34		35		36	
13													

A. Description of original monument and accessories and/or subsequent restoration:

I-1: U.S. Gov't survey by Burt, 1839, post witnessed by sugar 12 N66W 48, sugar 13 N72E 47. Tuller November 1873 found post and stone ran line north. Allyn, March 1906 found stake and stone. Waterman, 1908, found stake and stones ran south. Certificate of survey by Batzer 1980, Perla Stout Assoc 1972, and Glenn DeLaMater 1974. Witnessed by Grand Traverse County Road Commission, no date. Land corner record by Korr 1990, L003 P225.


B. Description of corner evidence found and/or method applied in restoring or reestablishing corner:

I-1: Section corner common to sections 3 and 2, T26N, R11W and sections 34 and 35, T27N R11W  
Found railroad spike over 3/4" iron pipe 2' south of centerline of Hoch Road. Fits witness from DeLaMater and Korr survey referenced above. This corner is accepted as a careful perpetuation of a locally accepted corner and is monumented with a 2 1/2"x30" flanged bottom galvanized pipe with a 3 1/4" brass cap stamped GRAND TRAVERSE COUNTY REMONUMENTATION.

C. Description of monument for corner and accessories established to perpetuate locating the position of the corner:

I-1: Section corner common to sections 2 and 3 T26N R11W, and sections 34 and 35, T27N R11W.  
Set 2 1/2"x30" flanged bottom galvanized pipe with a 3 1/4" brass cap stamped GRAND TRAVERSE COUNTY REMONUMENTATION in a monument box in centerline of Hoch Road

N 55° W 52.80'	Nail set in 6" maple
S 20 °W 57.95'	Nail set in 4" maple
S 11° E 35.99'	Nail found in power pole
N 7° W 32.20'	Nail set in triple 6" maple

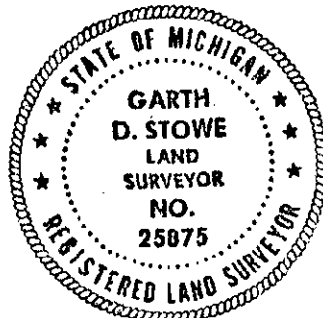

Corner approved by the Grand Traverse County Peer Review Group 12-22-97

Signed by Garth D. Stowe

Date 12-19-97

Surveyor's Michigan License No. 25875

UNANIMOUSLY ACCEPTED BY THE  
GRAND TRAVERSE COUNTY PEER  
REVIEW GROUP AS THE OFFICIAL  
CORNER UNDER MICHIGAN PUBLIC  
ACT 345 OF 1990 AT A MEETING  
HELD ON 10-22-97

Garth D. Stowe  
DARRELL E. MITCHELL SR. & PHILLIP J. JAMES

FORM APPROVED BY MICHIGAN STATE BOARD OF PROFESSIONAL SURVEYORS, JAN. 28, 1971  
REVISED MAY 14, 1975

REVISED JAN. 1983  
REVISED OCT. 1996