

## LAND CORNER RECORDATION CERTIFICATE

Filing Requirement of Act 74, Mich. PA 1970

STATE OF MICHIGAN  
GRAND TRAVERSE COUNTY  
RECORDED

30 DEC 99 3:54 P.M.

KARON ANDERSON  
REGISTER OF DEEDS

Register of Deeds Stamp &amp; File Number

For Corners In:  
Grand Traverse  
(County)

Located In

Corner Code #

1. Public Land Survey

T 27N R 9W F-6  
T R2. Property Controlling  
in SectionS T SURVEY &  
S T REMONUMENTATION3. Miscellaneous  
Property in SectionS T R  
S T MAR 22 2000

4. Lot No:

Recorded Plat:

SECTION

5. Private Claims:

I, Craig W. McVean, in a field survey on November 8, 1999 do hereby state that under requirements of PA 74, Michigan PA of 1970, the corner points mentioned in lines 1 and 2 above were in conformance with regulations and rules therefore as required in the current manual of survey instructions of the United States Department of the Interior, Bureau of Land Management or by a decree of a Court of Law and/or that the corner points mentioned in lines 3, 4 and 5 above were in conformance with the rules of the Michigan Board of Land Surveyors or by a Decree of a Court of Law; established, re-established, monumented, recovered, found as expressed below:

NOTE: Not more than 2 corners, all in the same town and range, may be recorded on this certificate.

	A	B	C	D	E	F	G	H	I	J	K	L	M
1													
2	6	5	4	3	2	1							
3													
4	7	8	9	10	11	12							
5													
6	18	17	16	15	14	13							
7													
8	19	20	21	22	23	24							
9													
10	30	29	28	27	26	25							
11													
12	31	32	33	34	35	36							
13													

A. Description of original monument and accessories and/or subsequent restoration:

F-6 -None

B. Description of corner evidence found and/or method applies in restoring or re-establishing corner:

F-6 - Center ¼ Sec. 16-Set 3 ¼" 'Grand Traverse Co. Remon.' Brass Cap on 2 ½" x 30" Galv. Iron Pipe in ring of cobble stones at the intersection of ¼ line per standard BLM procedure. CL. of N-S Williamsburg (Bit.) Rd. is 33'± W. 3 ¼" brass cap accepted the best available evidence of the position of the corner.

AS

C. Description of monument for corner and accessories established to perpetuate locating the position of the corner:

F-6 -3 ¼" 'Grand Traverse Co. Remon.' Brass Cap on 2 ½" x 30" galvanized Iron Pipe in ring of cobble stone.


Set Blue Carsonite 1' South

N58°W 99.48' to set N &amp; T in SW. side 7" W. Pine scribed 'XBT'

S55°W 93.25' to set N &amp; T in NW. side 5" W. Pine scribed 'XBT'

S20°E 72.92' to set N &amp; T in E. side 8" R. Pine scribed 'XBT'

N18°E 36.42' to set N &amp; T in E. side 5" R. Pine scribed 'XBT'

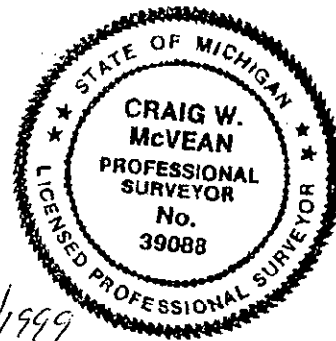

Signed by:

Craig W. McVean

Date:

12/13/1999

UNANIMOUSLY ACCEPTED BY THE  
GRAND TRAVERSE COUNTY PEER  
REVIEW GROUP AS THE OFFICIAL  
CORNER UNDER MICHIGAN PUBLIC  
ACT 345 OF 1990 AT A MEETING  
HELD ON 12/13/99

39088

ROBERT F. MITCHELL, P.S., Chairman