

11-11-1998

LAND CORNER RECORDATION CERTIFICATE
Filing Requirement of Act 74, Mich. P.A. 1970

SECTION

STATE OF MICHIGAN
GRAND TRAVERSE COUNTY
RECORDED

30 DEC 98 11:06 A.M.

KARON ANDERSON
REGISTER OF DEEDS

FOR CORNERS IN

GRAND TRAVERSE LOCATED IN: CORNER CODE #G-10
(COUNTY)

1. Public Land Survey E 1/4 cor SEC 28 , T 27 N R 10 W
East Bay Township

G.T. County Code 98-46

I, Corey J. Hughes, in a field survey performed in December, 1998, do hereby certify that under requirements of P.A. 74, Michigan P.A. of 1970, the corner point mentioned in lines 1 and 2 above was in conformance with regulations and rules therefore as required in the current manual of survey instructions of the United States Department of the Interior, Bureau of Land Management or by a decree of a Court of Law and /or that the corner points mentioned in lines 3, 4 and 5 above were in conformance with the rules of the Michigan Board of Land Surveyors or by a Decree of a Court of Law established, re-established, monumented, re-monumented, recovered, found as expressed below:

A. Description of original monument and accessories and/or subsequent restoration:

1852 GLO survey set post and wit: 8in Lynn N73W 41 and Beech S46E 9
1891 Stone set, Li 1, Pg 381 County Surveyors Book.
1907 Waterman fd stone at surface
1974 G.F. DeLamater found blue stone with X on top

B. Description of corner evidence found and/or method applied in restoring or reestablishing corner:

Found 5/8in re-bar over blue stone with X on top. Corner accepted as perpetuation of GLO position.


C. Description of monument for corner and accessories established to perpetuate locating the position of the corner:

Replaced 5/8in rod and stone with county remon post and cap.

Iron and cap #13030 on ROW West 33 ft
Centerline intersection of High Lake and Supply Roads
PK in face of PP N73E 81.16 ft
Nail in West side of 36in Maple S10E 104.52 ft
Spike in SE side of 36in Maple S28W 68.48 ft
PK in anchor pole S50W 33.48 ft

UNANIMOUSLY ACCEPTED BY THE
GRAND TRAVERSE COUNTY PEER
REVIEW GROUP AS THE OFFICIAL
CORNER UNDER MICHIGAN PUBLIC
ACT 345 OF 1990 AT A MEETING
HELD ON 11-11-98

Robert F. Mitchell
ROBERT F. MITCHELL, P.S., CHAIRMAN

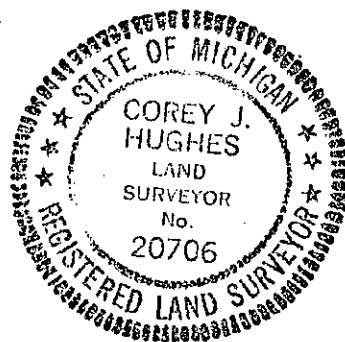

Corner approved by the Grand Traverse County Peer Review Group on November 11, 1998

Signed by *Corey J. Hughes* Date *12/29/98*
Corey J. Hughes, Michigan P.S. license No. 20706