

MICHIGAN
DEPARTMENT OF CONSERVATION
FORESTRY DIVISION

LAND CORNER RECORD

T. 27 N. R. 12 W


GRAND TRAVERSE COUNTY

DESCRIPTION OF CORNER Meander corner common to Sections 19-30 on E side Bellews Lake

CORNER MONUMENT Set 3' of 1" pipe in muck area; and squared cedar guard post.

DATE MONUMENT PLACED AND WITNESSED 2/7/68

WITNESSES TO CORNER.....

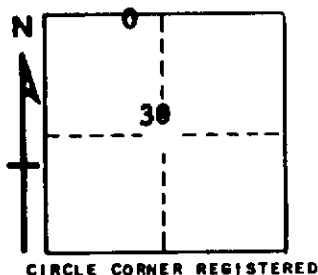

4" Cedar Due S 13.3'

7" Cedar S 70 E 11.6'

AND

Corner is 3.7' S of E-W Random Line

DESCRIPTION IN DETAIL AS TO HOW CORNER WAS LOCATED AND IDENTIFIED OR RESTORED.

This corner was set by single proportion between Sec. corner to west and 1/4 corner to east. Corner is 84' east of the present east shore of Bellew Lake.

SURVEYOR'S SEAL

SIGNED

Carl F. Roer

REGISTERED LAND SURVEYOR

#12028

DATE

7/17/68