

SURVEY &  
REMONUMENTATION

MAR 15 2000

SECTION

LAND CORNER RECORDATION CERTIFICATE  
Filing Requirement of Act 74, Mich. P.A. 1970

For corners in

Leelanau Located In: Corner Code #  
(County)

1. Public Land Survey T 28N R 11W E-9  
T R  
T R  
T R

2. Property Controlling S T R  
in Section S T R

3. Miscellaneous S T R  
Property in Sec. S T R

4. Lot No. , Recorded Plat  
5. Private Claims

Barbara Kirt 12/29/99  
Leelanau Res of Deeds 4:03 PM  
EJK Fee: 9.00  
04B00002 P0340 Page 1 of 1

#643

Register of Deeds Stamp & File Number

I, Victoria A. Brown, in a field survey on December 2, 19 99 do hereby state that under requirements of P.A. 74, Michigan P.A. of 1970, the corner points mentioned in lines 1 and 2 above were in conformance with regulations and rules therefore as required in the current manual of survey instructions of the United States Department of the Interior, Bureau of Land Management or by a decree of a Court of Law and /or that the corner points mentioned in lines 3, 4 and 5 above were in conformance with the rules of the Michigan Board of Land Surveyors or by a Decree of a Court of Law, established, re-established, monumented, recovered, found as expressed below:

NOTE: Not more than 2 corners, all in the same town and range, may be recorded on this certificate.

A. Description of original monument and accessories and/or subsequent restoration:

E-9: Southeast corner Section 20

G.L.O. notes: Set post to sections 20, 21, 28, 29 at 80.00 chains  
Birch 36 S73°W, 4 links  
Birch 12, N12°E, 23 links

B. Description of corner evidence found and/or method applied in restoring or reestablishing corner:

E-9: Southeast corner of Section 20.

H. Brehmer (1940's) County Surveyor notes - Stone with cross at corner. Found 1/2" iron rod (Batzer, 1985). Also used by R. Max Harris and H. Walker(1995).

Witnesses: (Brehmer)  
6" Maple S12°45'E 62.0'  
28" Elm S63°45'E 123.8'  
18" Maple S62°05'W 49.7'

APPROVED LAND CORNER  
P.A. 345 OF 1990  
LEELANAU COUNTY

DATE: 12-8-99


COUNTY REP. H. M. O'Han

C. Description of monument for corner and accessories established to perpetuate locating the position of the corner:

E-9: Southeast corner of Section 20.

Found 1/2" iron rod in centerline of Breithaupt Road and on fenceline south. 1/2" iron rod accepted as the best available evidence of the position of the original corner by the Leelanau County Remonumentation Peer Review Group on December 8, 1999 and remonumented with a 3/4" galvanized iron pipe, 3' long, with a brass cap.

Existing Witnesses:  
10" Cedar, N45°W, 51.03'  
P. Pole, N63°W, 62.92'  
14" Cedar, S52°W, 43.72'  
P. Pole, S22°E, 68.30'

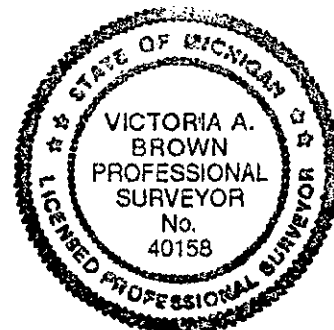

Signed by Victoria A. Brown  
Surveyor's Michigan License No. 40158

Date 12/27/99