
LAND CORNER RECORDATION CERTIFICATE

FILING REQUIREMENT OF ACT 74, MICH. P.A.1970

FOR CORNERS OF	-: L	OCATED IN-:	CORNER CODE NUMBER	
1. PUBLIC LAND	SURVEYT.	51 N., R. 35 W.	C9 & D9	·
2. PROPERTY CO. ING IN S	NTROLL- SECTION,T.	N. E. W.		
				1
4. LOT NO	, RECORDE	D PLAT		
5. PRIVATE CLAIR	4s			REGISTER OF DEEDS STAMP AND FILING NUMBER
field survey on restored as expre of survey instruct court of law. formance with the law: A. Description of Corners C9 corner. Fo	sed below and in tions of the United Furthermore, that ——————————————————————————————————	es I and 2 above (identification) conformance with regular states Department of the corner points may be a considered, restored, end accessories and accessories and mo evidence of or ement monuments of the corner points are stated and accessories access	titled with circles on index l, re-established, monumented lations and rules therefore a the Interior, Bureau of Landentioned in lines 3, 4 and 5 stablished or re-established egistration for Land Surveyor or subsequent restoration: Tiginal posts or their accessories at eith	P.A. 74, Michigan P.A. of 1970, code diagram - over) were, in a ed, re-monumented, recovered or s required in the current manual Management or by a decree of a above were, in a field survey on as expressed below and in contra or, by a Decree of a Court of accessories at either er corner. All evidence
presumed de	stroyed by ro	ad construction a	etivity.	
Corner C9: R mined from ol section. The from the acts point is not position woul Corner D9: R property line of a county r C. Description of Corner C9: 1' Po	e-established d fence lines roads are pro of abutting proportionate d be 1.03 ch. e-established of long stand oad. Corner if 2013'30" define " I.D. x 24" if ower Pole S130 ower Pole N360" " I.D. x 24"	at intersection of intersecting esumed to be on the land owners to be ly spaced between E and .78 ch. Notice in line with an inline, and midway last 40.364 ch. Worker and accessories estate in line with 3½ (mag.) 32.97 few (mag.) 78.08 few iron pipe with 3½ s10°E (mag.) 30.	county roads running he section lines by c accepted locally as corners to N and S o of this point. old N & S fence to S, between old E & W fen	on centerlines, as deter- E & W and S from inter- ommon report, and appear the section lines. This f it nor E & W of it; that which appears to be a ce lines on N & S sides 39.889 ch. E of sec. cor. the first road bed. /4" brass "WITNESS MARK" ed in road bed. th 3/4" brass
SIGNED BY			DATE	
SURVEYOR'S MIC	HIGAN REGISTRA	ATION NO.		(SEAL)
FOR STATE AND	UNITED STATES	AGENCIES:		ARTHUR ARTHUR
SIGNED BY	CHIE	F OF SURVEY FARTY	DATE	ARTHUR O ENGER
APPROVED AND S	SIGNED BY	Arthur O. En		May 22, 1975 +
	MICHIG	AN DEPARTMENT OF	NATURAL RESOURCES	No 1358) 1358) 1358) 1358) 1358)
SURVEYOR'S MICH Form No. ML M735 Print Even mank & Co., RAL		FORM A	PPROVED BY MICHIGAN STATE BOAI	


CORNER NUMBERING CODE DIAGRAMS FOR IDENTIFYING LAND CORNER RECORDATIONS AND INDEXING

FOR PUBLIC LAND SURVEY CORNERS IN THE T.51N , R. 35W (MENTIONED OVER)

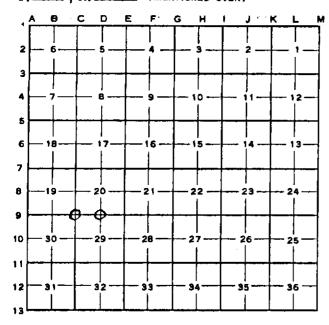

Apply letter prefix for corner points encircled above for identifying corner recordation numbers over.

FOR PROPERTY CONTROLLING AND MISC, PROPERTY CORNERS WITHIN THE SECTION (MENTIONED OVER AND EXCLUDE LOT CORNER)

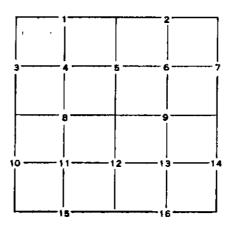

- 1. Above coded numbers are positioned on 1/16 fractional lines of the section.
- 2. Township corner code numbers shall be applied to corners of above typical section not numbered.
- Miscellaneous property corners within a section, located at points other than numbered above, shall be referenced to at least two of above corner code numbers.
- 4. Private claim corners to be tied to rectangular land corners if possible sketch required below.

EXPLANATORY SKETCH IF NECESSARY -- BELOW

· ·	