


LAND CORNER RECORDATION CERTIFICATE
Authority: 1970 PA 74, MCL 54.205

Surveyor's Name: Stephan J. Szyszkoski
Field Survey Date: October 20, 2016
For corner(s) in: Houghton County

Table with 4 columns: Original Public Land Survey Corner, Corner Code, Property Corner, 1/16 Corner Code. It lists survey points with bearings and distances, and their corresponding corner codes.

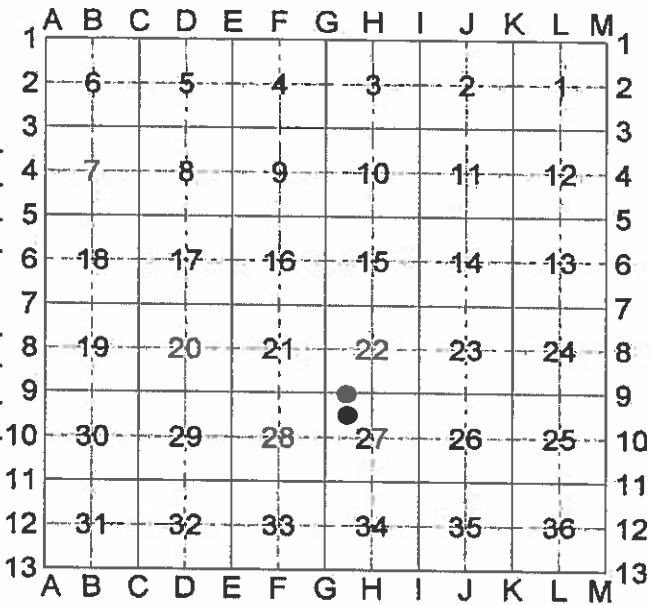

Part A. Corner History

- a.) Northwest 1/16 corner, Section 27. Not previously monumented.
b.) West 1/16 corner between Sections 22 and 27. Not previously monumented.

Part B: Surveyor's Report on Perpetuation, Restoration, Reestablishment, or Monumentation of Corner

- a.) Established the position for the corner at the intersection of straight lines connecting opposite 1/16 corners, all monumented.
b.) Established the position for the corner midway and on the section line between Section corner 1317.18' west and Quarter corner 1317.18' east.

Part C: Field Evidence of Perpetuation or Monumentation of Corner

- (a.) Set 1"IDx28" I.pipe with 2" alum. MDNR cap. Set measuring nail with MDNR tag in the side of: 9" Cedar N25°E 11.05' mrkd "1/16S BT"
(b.) Set 1"IDx28" I.pipe with 2" alum. MDNR cap. Set measuring nail with MDNR tag in the side of: 8" Maple N06°E 5.1' mrkd "1/16S BT"

Bearings are magnetic. Coordinates are MCS83, NAD83(2011) Epoch 2010.00, in meters.
Coordinate Reference: NGS PID RL0502, E= 7857774.767 m. N= 234995.272 m.

Signature of Stephan J. Szyszkoski
11/03/2016

