

MICHIGAN
DEPARTMENT OF CONSERVATION
FORESTRY DIVISION

LAND CORNER RECORD

T. 52 N. R. 36 W.


Houghton COUNTY

DESCRIPTION OF CORNER M.C. for Sections 22, 23

CORNER MONUMENT 1 1/2" Iron Pipe

DATE MONUMENT PLACED AND WITNESSED 10-21-63

WITNESSES TO CORNER..... 6" S. Maple (MC) (NBT) N 51° E 41 links

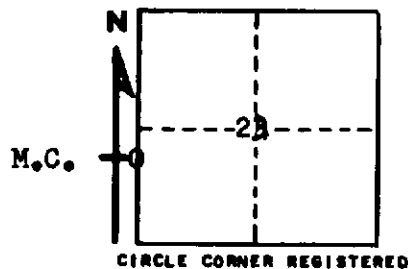

6" S. Maple (MC) (NBT) S 29° E 42 links

AND

DESCRIPTION IN DETAIL AS TO HOW CORNER WAS LOCATED AND IDENTIFIED OR RESTORED.

This Corner was set by M. C. Larsen, Hancock.

Found possible W.Pine B.T. (down burnt & rotted) in proper position.

SURVEYOR'S SEAL

SIGNED Billy D. Buckler DATE April 27, 1964
REGISTERED LAND SURVEYOR
Billy D. Buckler