

DEC 14 1998

LAND CORNER RECORDATION CERTIFICATE

Filing Requirement of Act 74, Mich. P.A. 1970

SECTION

Nov. 6, 1998
Robert W. Crampton
For corners in

Houghton County

Located in:

Corner Code #

1. Public Land Survey

T53N R32W

MC E3-F3 Z2

ROBERT F. MIKESCH 11/11/98

HOUGHTON COUNTY, REGISTER 09:42

LC 3/ 524 PAU Fee: 9.00

Page 1 of 1

2. Property Controlling
in Section

S

T R

#15

3. Miscellaneous
Property in Sec.

S

T R

4. Lot No. , Recorded Plat

5. Private Claims

Register of Deeds Stamp & File Number

	A	B	C	D	E	F	G	H	I	J	K	L
1												
2	6			5		4		3		2		1
3					•							
4	7			8	•	9		10		11		12
5												
6	18			17		16		15		14		13
7												
8	19			20		21		22		23		24
9												
10	30			29		28		27		26		25
11												
12	31			32		33		34		35		36
13												

I, Steven C. Hein, in a field survey on September 4, 1998, do hereby state that under requirements of P.A. 74, Michigan P.A. of 1970, the corner points mentioned in lines 1 and 2 above were in conformance with regulations and rules therefore as required in the current manual of survey instructions of the United States Department of the Interior, Bureau of Land Management or by a decree of a Court of Law and/or that the corner points mentioned in lines 3, 4 and 5 above were in conformance with the rules of the Michigan Board of Land Surveyors or by a Decree of a Court of Law; established, re-established, monumented, recovered, found as expressed below:

NOTE: Not more than 2 corners, all in the same town and range, may be recorded on this certificate.

A. Description of original monument and accessories and/or subsequent restoration:

MC E3-F3 Z2: From original notes: East between Sections 4 & 9; 29.83 Intersect Keweenaw Bay; Fir 7 for Meander Corner on ledge of sand rock about 15 feet high; fir 3 N20W 11. No evidence of original corner or accessories found.

MC E3-E4 Z3: From original notes: South between Sections 8 & 9; 25.40 Intersect Keweenaw Bay; Spruce 7 for Meander Corner on vertical ledge of sand rock about 65 feet high; Spruce 10 N25W 06. No evidence of original corner or accessories found.

B. Description of corner evidence found and/or method applied in restoring or reestablishing corner:

MC E3-F3 Z2: Found 1/2" capped pipe, P.S. 24591, 5" A.G., 10' East to ledge, as shown on survey by R. W. Crampton dated July 17, 1996. Witnesses as shown on survey: 5" Maple N20°W 39.66'; 6" W. Birch S77°W 44.25'; 5" Maple N75°W 27.13'; 5" Balsam N52°W 3.48'

MC E3-E4 Z3: found 1 1/4" pipe, 24' South to top of ledge, pipe fits W. W. Stockley breakdown of Section 8 from around 1920. No apparent Witnesses. Accepted pipe as best available evidence of line between Sections 8 & 9.

C. Description of monument for corner and accessories established to perpetuate locating the position of the corner:

MC E3-F3 Z2: Set 2 1/4" Brass Cap on 3/4" pipe, 6" A.G., 10' East to ledge

Witnesses (check):

5" R. Maple N23°W 39.64'

6" W. Birch S77°W 44.21'

5" R. Maple N80°W 27.13'

5" Balsam N52°W 3.48'

MC E3-E4 Z3: Set 2 1/4" Brass Cap on 3/4" pipe

4" A.G., 24' South to top of ledge

Witnesses:


6" W. Birch N54°E 9.29'

6" Balsam S86°W 20.85'

9" W. Birch N51°W 33.39'

20" R. Maple N04°W 25.23'

Reset 1 1/4" pipe 1' So. of Brass Cap

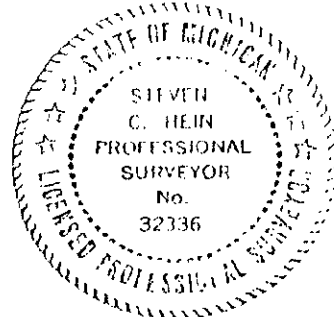

Bearings are compass bearings, corrected for declination, all distances are to a nail and tag in the side of the witness object unless otherwise noted.

Signed by

Steven C. Hein

Date

Oct. 31, 1998

Surveyor's Michigan License No. 32336

FORM APPROVED BY MICHIGAN STATE BOARD OF PROFESSIONAL SURVEYORS, JAN. 28, 1971
REVISED MAY 14, 1975
REVISED JAN., 1993
REVISED OCT., 1995