

LAND CORNER RECORDATION CERTIFICATE

Authority: 1970 PA 74, MCL 54.205

Surveyor's Name: Stephan J. Szyszkoski

Field Survey Date: May 11 2017

For corner(s) in: Houghton County

Original Public Land Survey Corner

Corner Code


S T R
S T R
S T R
S T R

Property Corner

1/16 Corner Code

a. S 25 T 53N R 35W
S T R
b. S 25 T 53N R 35W
b. S 30 T 53N R 34W

9 (GCDB 660240)
7 (GCDB 700260)
3 (GCDB 100260)

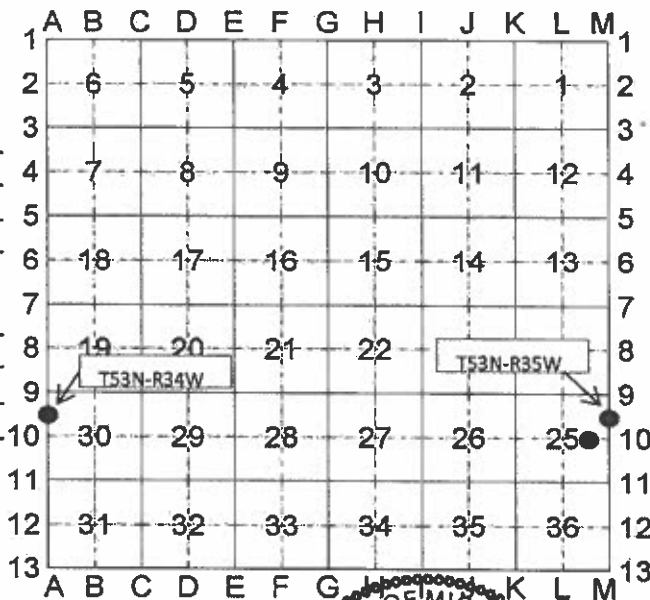

Part A. Corner History

a.) Center-East 1/16 corner, Section 25. Not previously monumented.

b.) North 1/16 corner between Section 25 T53N-R35W and Section 30 T53N-R34W. Not previously monumented.



Part B: Surveyor's Report on Perpetuation, Restoration, Reestablishment, or Monumentation of Corner

a.) Established the position for the corner midway and on a straight line between Quarter corner 1289.48' east and Center of Section 25 1289.48' west.

b.) Established the corner midway and on the Range line between Section corner 1319.35' north and Quarter corner 1319.35' south.

Part C: Field Evidence of Perpetuation or Monumentation of Corner

a.) Set 1"IDx28" I.pipe with 2" alum. MDNR cap.
Set measuring nail with MDNR tag in the side of:
11" Maple N17°E 15.65' mrkd "1/16S BT"
5" Maple S52°E 3.65' do
4" Y.Birch S40°W 16.1' do
8" Maple N43°W 14.95' do
Set sq'd cedar post adjacent.
E= 7871835.182 N= 243339.795

b.) Set 1"IDx28" I.pipe with 2" alum. MDNR cap.
Set measuring nail with MDNR tag in the side of:
6" Sugar N21°E 12.8' mrkd "1/16S BT"
10" twin Sugar S57°E 9.6' do
6" Sugar S70°W 15.15' do
6" Y.Birch N42°W 6.3' do
Set sq'd cedar post adjacent.
E= 7872237.907 N= 243739.837

Bearings are magnetic. Coordinates are MCS83 in meters, NAD83(2011) Epoch 2010.00 datum.

Coord. Ref.=NGS PID D08499: N= 221257.624 m. E= 7884435.169m.

Stephan J. Szyszkoski

05/30/2017

Professional Surveyor's License No.: 33986

page 1 of 1

Prepared By: S.J. Szyszkoski for the Michigan Dept. of Natural Resources, 427 N. US41 Baraga, MI 49908