

LAND CORNER RECORDATION CERTIFICATE

Authority: 1970 PA 74, MCL 54.205

Surveyor's Name: Stephan J. Szyszkoski

Field Survey Date: May 11 2017

For corner(s) in: Houghton County

Original Public Land Survey Corner


Corner Code

S	T	53N	R	35W	M7 (GCDB 700400)
S	T	53N	R	34W	A7 (GCDB 100400)
S	T		R		
S	T		R		

Property Corner

1/16 Corner Code

S	T		R		
S	T		R		
S	T		R		
S	T		R		

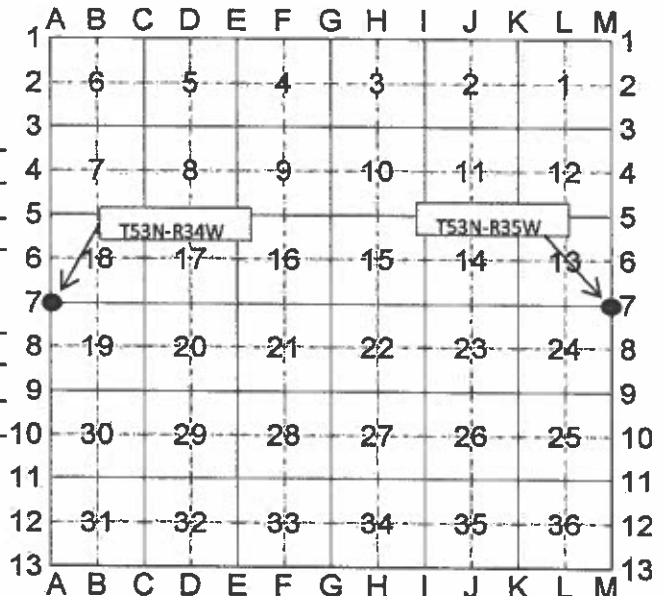

Part A. Corner History

Section corner common to Sections 13-24 T53N-R35W and Sections 18-19 T53N-R34W. 1957-Original corner position perpetuated by Billy D. Buckler, RLS: Replaced section corner from one Yellow Birch B.T. bearing S65°W 20 links in poor condition. Found two Hemlock B.T.s down and in poor condition bearing S74°E 21 links and N41°W 47 links. Set 1"ID iron pipe with 4" brass cap. 16" Hard Maple S02°W 55 links, 15" Hard Maple N36°E 57 links.

Part B: Surveyor's Report on Perpetuation, Restoration, Reestablishment, or Monumentation of Corner

Found the 1957 monument in good condition and at substantial record bearing and distance from the 1957 Sugar NBT N36°E 57 links, in good condition with double overgrown blazes. Accepted the monument as a careful and faithful perpetuation of the position of the original corner.

Part C: Field Evidence of Perpetuation or Monumentation of Corner

Found 1"ID Iron pipe with 4" brass Michigan Dept. of Conservation cap, appropriately stamped to identify the corner. Set measuring nails with MDNR tags in the side of:

22" Sugar N44°E 38.4'	old blazes (the 1957 NBT)
7" Sugar N55°E 7.85'	mrkd "S18 NBT"
10" Sugar S10°E 20.6'	"S19 NBT"
8" Basswood S68°W 4.3'	"S24 NBT"

Set sq'd cedar post adjacent.

E= 7872279.961 N= 245750.456

Bearings are magnetic. Coordinates are MCS83 in meters, NAD83(2011) Epoch 2010.00 datum.

Coord. Ref.=NGS PID D08499: N= 221257.624 m. E= 7884435.169m.



Stephan J. Szyszkoski

05/30/2017

Professional Surveyor's License No.: 33986

page 1 of 1

Prepared By: S.J. Szyszkoski for the Michigan Dept. of Natural Resources, 427 N. US41 Baraga, MI 49908