

SURVEY & REMONUMENTATION

JUL 23 1999

SECTION

APPROVED LAND CORNER
P.A. 345 of 1990
Houghton County

April 30, 1999

Robert W. Campbell

LAND CORNER RECORDATION CERTIFICATE Filing Requirement of Act 74, Mich. P.A. 1970

For corners in

Houghton County
(County)

Located In:

Corner Code #

MARY SCHOOS 05/05/99 2
HOUGHTON COUNTY, REGISTER 15:06
LC 3/ 591 PAU Fee: 9.00
Page 1 of 1

1. Public Land Survey Section 7 T 54N R 32W A-4, 5
T R (Meander Corner)
T R
T R
2. Property Controlling S T R
in Section S T R
3. Miscellaneous S T R
Property in Sec. S T R

4. Lot No. , Recorded Plat
5. Private Claims

Corner A-4, 5 is the meander corner on the E. shore of Portage Lake, on section line (also Range line) common to Section 7, T54N, R32W & Section 12, T54N, R33W.

I, Michael T. Drewyor, in a field survey on December 29, 19 97 do hereby state that under requirements of P.A. 74, Michigan P.A. of 1970, the corner points mentioned in lines 1 and 2 above were in conformance with regulations and rules therefore as required in the current manual of survey instructions of the United States Department of the Interior, Bureau of Land Management or by a decree of a Court of Law and/or that the corner points mentioned in lines 3, 4 and 5 above were in conformance with the rules of the Michigan Board of Land Surveyors or by a Decree of a Court of Law; established, re-established, monumented, recovered, found as expressed below:

NOTE: Not more than 2 corners, all in the same town and range, may be recorded on this certificate.

A. Description of original monument and accessories and/or subsequent restoration:

Meander Corner - At 25.25 chains (meas. from S), intersect East arm of Portage Lake, course of coast SW & NE, set meander post.

Aspen 10, S 65° E, 25

No evidence of original monument or accessories. This line was originally surveyed by Deputy Surveyor William A. Burt, June 28, 1845.

B. Description of corner evidence found and/or method applied in restoring or reestablishing corner:

Meander Corner - Found 1 1/2" OD (1" ID) iron pipe 5" above grade along old fence line running North and South. This corner is located along the Westerly side of the yard at Fire Number 207 on Bootjack Road.

C. Description of monument for corner and accessories established to perpetuate locating the position of the corner:

All witness points in trees are PK nails and washers.

Meander Corner - Found 1" ID iron pipe (description above).

Witnesses:

- S 71° E, 28.68 ft., 26" White Pine
- S 31° E, 63.67 ft., NE Building Corner Frame Sauna
- S 11° W, 32.48 ft., 11" Cedar
- S 86° W, 5.89 ft., 10" Fir

Signed by


Michael T. Drewyor

Surveyor's Michigan License No.

24245

Date

April 13, 1999

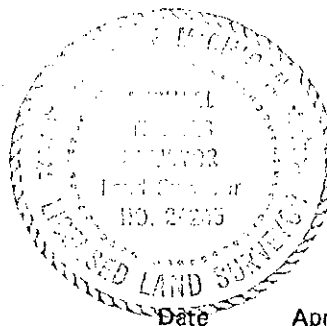

	A	B	C	D	E	F	G	H	I	J	K	L	M
1													
2	6			5		4		3		2		1	
3													
4	7			8		9		10		11		12	
5													
6	18			17		16		15		14		13	
7													
8	19			20		21		22		23		24	
9													
10	30			29		28		27		26		25	
11													
12	31			32		33		34		35		36	
13													

Corner A-4, 5
Meander Corner #5