

DEC 14 1998

SECTION

LAND CORNER RECORDATION CERTIFICATE

Filing Requirement of Act 74, Mich. P.A. 1970

For corners in
Houghton
(County)

Located In:

Corner Code #

1. Public Land Survey

T 54N R 33W

K-8

T _____ R _____

T _____ R _____

T _____ R _____

2. Property Controlling
in Section

S _____ T _____ R _____

S _____ T _____ R _____

3. Miscellaneous

S _____ T _____ R _____

Property In Section

S _____ T _____ R _____

ROBERT F. MIKESCH 11/11/98

HOUGHTON COUNTY, REGISTER 09:39

LC 3/ 514 PAU Fee: 9.00

Page 1 of 1

Register of Deeds Stamp & File Number

4. Lot No. _____, Recorded Plat _____

5. Private Claims _____

I, Ronald S. Haataja, in a field survey on August 4, 19 98

do hereby certify that under requirements of P.A. 74, Michigan P.A. of 1970, the corner points mentioned in lines 1 and 2 above were in conformance with regulations and rules therefore as required in the current manual of survey instructions of the United States Department of the Interior, Bureau of Land Management or by a decree of a Court of Law and/or that the corner points mentioned in lines 3, 4 and 5 above were in conformance with the rules of the Michigan Board of Professional Surveyors or by a Decree of a Court of Law; established, re-established, monumented, re-monumented, recovered, found as expressed below:

NOTE: Not more than 4 corners, all in the same town and range, may be recorded on this certificate.

A. Description of original monument and accessories and/or subsequent restoration:

(K-8) E 1/4 Corner Section 23, T54N-R33W

40.00 Set Quarter Section post

Witnesses: Hemlock 24" S34°W 9 lks.

Yellow Birch 10" N71°E 24 lks.

B. Description of corner evidence found and/or method applied in restoring or reestablishing corner:

(K-8) E 1/4 Corner Section 23, T54N-R33W

Found 2" Pipe 14" above ground and according to LCRC Liber 2, Page 477.

C. Description of monument for corner and accessories established to perpetuate locating the position of the corner:

(K-8) E 1/4 Corner Section 23, T54N-R33W


Stamped and cemented a brass remon. cap into pipe

Witnesses: Brass tags PS#39478 nailed into side of trees

4" Maple S03°W 1.65', 6" Maple S67°W 8.95',

10" Oak N18°W 5.40'; 7" maple S89°E 29.35',

12'± West of 2-Track road centerline

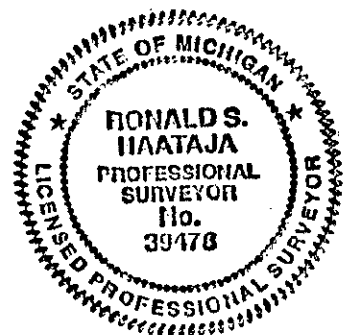

Signed by Ronald S. Haataja

Date November 6, 1998

Surveyor's Michigan License No. 39478