

SURVEY &
REMONUMENTATION

LAND CORNER RECORDATION CERTIFICATE
Filing Requirement of Act 74, Mich. P.A. 1970

SEP 17 1999

For corners in

Houghton

(County)

Located In: 27

Corner Code #

SECTION

1. Public Land Survey

T 54N R 33W

I-11

T R

T R

T R

T R

2. Property Controlling
in Section

S

T R

S

T R

3. Miscellaneous
Property in Sec.

S

T R

S

T R

MARY SCHOOS 05/19/99 2
HOUGHTON COUNTY, REGISTER 13:54
LC 3/ 604 PAU Fee: 9.00
Page 1 of 1

Register of Deeds Stamp & File Number

4. Lot No. , Recorded Plat
5. Private Claims

I, Robert A. Goodreau in a field survey on September, 1998 do hereby state that under requirements of P.A. 74, Michigan P.A. of 1970, the corner points mentioned in lines 1 and 2 above were in conformance with regulations and rules therefore as required in the current manual of survey instructions of the United States Department of the Interior, Bureau of Land Management or by a decree of a Court of Law and /or that the corner points mentioned in lines 3, 4 and 5 above were in conformance with the rules of the Michigan Board of Land Surveyors or by a Decree of a Court of Law; established, re-established, monumented, recovered, found as expressed below:

NOTE: Not more than 2 corners, all in the same town and range, may be recorded on this certificate.

A. Description of original monument and accessories and/or subsequent restoration:

I-11 Post set - 1845 by D. Houghton.

Fir, 9", N41°E, 18 LKS

Yellow Birch, 6", S72°W, 31 LKS

Per Land Corner recordation certificate by Robert W. Crampton

2" Iron pipe (FND) witness with survey tag nailed to 4" balsam fir tree N06°W, 18.68'

5" Balsam fir tree N33°E, 21.58'

12" Basswood tree S53°E, 41.20'

6" Spruce tree S40°W, 41.62'

No original evidence found.

B. Description of corner evidence found and/or method applied in restoring or reestablishing corner:

I-11 Found 1 1/2" I.D. iron pipe, standing 1' above ground marked by L.S. 24591 tag in trees & Keweenaw Land
Accepted corner as found.

C. Description of monument for corner and accessories established to perpetuate locating the position of the corner:


I-11 Set 2" Brass remon cap. Witness set with 60d nail, brass "UPEA" tags, chest blaze.

Yellow Birch, 20" SCR. NBT N40°W, 9.02'

White Ash, 10", SCR. NBT, N57°E, 9.54'

Hemlock, 10", SCR. NBT, S09°E, 36.59'

Hemlock, 8", SCR. NBT, S62°W, 18.73'

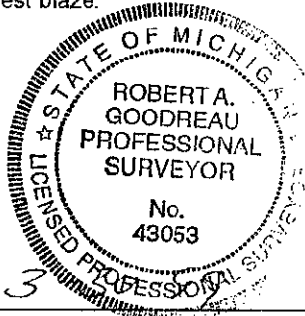

Signed by

Robert A. Goodreau

Date

3

Surveyor's Michigan License No. 43053