

LAND CORNER RECORDATION CERTIFICATE
Filing Requirement of Act 74, Mich. P.A. 1970 as Amended

For corners in

Houghton (County)	Located In:	Corner Code #
1. Public Land Survey	T 55N R 32W T 55N R 32W T 55N R 33W	C7 MC-10 } same MC-13 } corner
2. Property Controlling in Section	S T R S T R S T R	
3. Miscellaneous Property in Sec.	S T R S T R	
4. Lot No. _____, Recorded Plat _____		
5. Private Claims _____		

Register of Deeds Stamp & File Number

1	A	B	C	D	E	F	G	H	I	J	K	L	M
2	6	5	4	3	2	1							
3													
4	7	8	9	10	11	12							
5													
6	18	17	16	15	14	13							
7													
8	19	20	21	22	23	24							
9													
10	30	29	28	27	26	25							
11													
12	31	32	33	34	35	36							
13													

I, Stephan J. Szyszkoski, in a field survey on MC-10 07/25/2011 do hereby state that under requirements of P.A. 74, Michigan P.A. of 1970, the corner points mentioned in lines 1 and 2 above were in conformance with regulations and rules therefore as required in the current manual of survey instructions of the United States Department of the Interior, Bureau of Land Management or by a decree of a Court of Law and /or that the corner points mentioned in lines 3, 4 and 5 above were in conformance with the rules of the Michigan Board of Land Surveyors or by a Decree of a Court of Law; established, re-established, monumented, recovered, found as expressed below:

NOTE: Not more than 2 corners, all in the same town and range, may be recorded on this certificate.

A. Description of original monument and accessories and/or subsequent restoration:

(C7) Corner common to Sections 17-18-19-20. November, 1997 - A 2 1/4" brass cap on a 3/4" pipe set by S.C.Hein PS 32336, approved by the Houghton County Peer Group on Dec. 10, 1997, and recorded in L.3 of LCR, Page 440, Houghton County Records. Witnesses: 1/2" rebar North 199.27', 12" Maple N52E 70.20', 8" Balsam S53W 77.58', Util Pole N55W 57.38'.

(MC-10) Witness corner to the original Meander Corner between Section 19 T55N-R32W and Section 24 T55N-R33W on the south shore of Torch Lake. Sept. 2006 - A Brass Houghton County Remonumentation Cap on a 5/8" pin set by R.S.Haataja PS 39478, approved by the Houghton County Peer Group on 12/28/2006, and recorded in 2007R-00205, Houghton County Records. Witnesses: 12" W.Birch bark scribed "XBT" N65E 25.78', 8" Ash "XBT" S66E 18.60', 12" Y.Birch "XBT" S33W 22.55', 3" Red Maple "XBT" S72W 6.77'.

B. Description of corner evidence found and/or method applied in restoring or reestablishing corner:

(C7) Found a 2 1/4" Brass Houghton County cap set flush to the ground surface, at record bearing and distance from the 1997 witness Utility pole N55W and 12" Maple N52E. Accepted the monument as marking the position for the corner and made two new witnesses as described below. Did not check the measurement to the witness rebar 199.27' north.

(MC-10) The 2006 monument was not recovered and it appears to have been removed. Remonumented the corner at the 2006 position at record bearing and distance from the three remaining 2006 witnesses found as described below.

C. Description of monument for corner and accessories established to perpetuate locating the position of the corner:


(C7) Fd. 2 1/4" brass cap on 3/4" pipe.
Fd. nail and tag in:
Power Pole N55W 57.4'
11" Maple N52E 70.2' overgrown blazes.
Set nail and MDNR tag in the side of:
6" W.Birch S71W 27.7' mrkd "S19 NBT"
7" Oak N07E 78.9' "S17 NBT"
Bearings are magnetic.

(MC) Set 5/8"x24" rebar with plastic MDNR cap.
Fd. measuring nail/tag 39478 in the side of:
10" W.Birch N66E 25.78' scribing visible
7" Ash S64E 18.60' do
4" Maple S76W 6.78' do
Set measuring nail with MDNR tag in the side of:
4" Apple N71W 6.9' mrkd "WC BT"
Set sq'd cedar post adjacent.
Bearings are magnetic.

Signed by Stephan J. Szyszkoski
Surveyor's Michigan License No. 33986

Date 11/17/2011

For the Michigan Department of Natural Resources, Forest Management Division

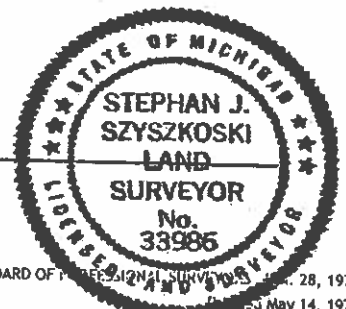

16776

16774