

APPROVED LAND CORNER
P.A. 348 OF 1990
Houghton County

Robert W. Crampton
DEC. 10, 1997

SURVEY &
REMONUMENTATION

SEP 17 1999

LAND CORNER RECORDATION CERTIFICATE
Filing Requirement of Act 74, Mich. P.A. 1970

SECTION

For corners in

HOUGHTON
(County)

Located in:

Corner Code #

NANCY FENILI 12/11/97
HOUGHTON COUNTY
LC 3/ 442 PAU Fee: 11:19
Page 1 of 1 9.00

1. Public Land Survey

T_{55N} R_{32W} MC C6-C7 2-8 19
T_{55N} R_{32W} MC B7-C7 2-9 16

2. Property Controlling
in Section

S₋₋₋ T₋₋₋ R₋₋₋
S₋₋₋ T₋₋₋ R₋₋₋
S₋₋₋ T₋₋₋ R₋₋₋
S₋₋₋ T₋₋₋ R₋₋₋

3. Miscellaneous
Property in Sec.

4. Lot No. _____, Recorded Plat _____
5. Private Claims _____

November 20, 1997

I, Steven C. Hein, in a field survey on _____, 19____ do hereby state that under requirements of P.A. 74, Michigan P.A. of 1970, the corner points mentioned in lines 1 and 2 above were in conformance with regulations and rules therefore as required in the current manual of survey instructions of the United States Department of the Interior, Bureau of Land Management or by a decree of a Court of Law and/or that the corner points mentioned in lines 3, 4 and 5 above were in conformance with the rules of the Michigan Board of Land Surveyors or by a Decree of a Court of Law; established, re-established, monumented, recovered, found as expressed below:

NOTE: Not more than 2 corners, all in the same town and range, may be recorded on this certificate.

	A	B	C	D	E	F	G	H	I	J	K	L	M
1													
2	6		5		4		3		2		1		
3													
4	7		8		9		10		11		12		
5													
6	18		17		16		15		14		13		
7													
8	19		20		21		22		23		24		
9													
10	30		29		28		27		26		25		
11													
12	31		32		33		34		35		36		
13													

A. Description of original monument and accessories and/or subsequent restoration:

(MC C6-C7) From Original notes: North 14.00 Intersect Lake; Cedar 7 for Meander Corner; Hemlock 12 S18E 21. No evidence of original corner. In a September 10, 1996 survey, S. C Hein, P.S. found, accepted and recorded a 1 1/2" pipe in Liber 3 of L.C.R.C., page 375.
(MC B7-C7) From Original notes: 13.06 Intersected Lake; Set Meander post; White Pine 12 S03E 18; Do 14 N39E 22. No evidence of original corner. In a July 6, 1993 survey, Robert W. Crampton, P.S. 24591 found and accepted a 1 1/2" pipe used by Duane Peterson in a September 8, 1978 survey.

B. Description of corner evidence found and/or method applied in restoring or reestablishing corner:

(MC C6-C7) Found and accepted 1 1/2" pipe, 9' North and 10' West to Torch Lake as recorded. Found witnesses as shown below. Replaced 1 1/2" pipe with Houghton County Remonumentation brass cap.
(MC B7-C7) Found 1 1/2" pipe, 5' North and 5' West to Torch Lake, as recorded by R. W. Crampton, P.S. 24591 in Liber 3 of L.C.R.C., page 119. Found Witnesses: 6' W. Birch S12E 64.93'; 9' Cedar S10W 29.97'; 12' Hemlock N44E 16.13'; 6' Cedar N89E 11.38'. Replaced 1 1/2" pipe with Houghton County Remonumentation brass cap.

C. Description of monument for corner and accessories established to perpetuate locating the position of the corner:

(MC C6-C7) Set 2 1/4" Brass cap on 3/4" pipe

Witnesses of record:

8" Cedar N13E 3.63'

6" Cedar S28E 5.12'

8" Spruce S21W 40.44'

5" Cedar N43W 4.78'

Witnesses have nail & tag #32336

(MC B7-C7) Set 2 1/4" Brass cap on 3/4" pipe


Witnesses of record:

12" Hemlock N44E 16.13' (16.14' meas.)

6" Cedar N89E 11.38' (11.27' meas.)

6" W. Birch S12E 64.93' (64.69' meas.)

9" Cedar S10W 29.97' (29.85' meas.)

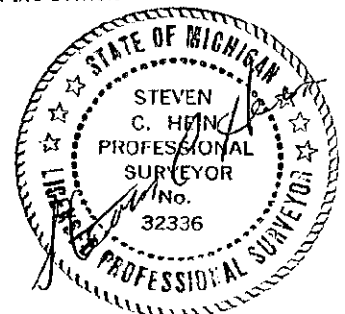

Signed by Steven C. Hein
Surveyor's Michigan License No. 32336

Date NOV. 25, 1997